


CERTIFIED LAND CORNER RESTORATION

Index No. E-3

State of Wisconsin }
County of Lincoln } ss.

I, Lester J. Schmit, do hereby certify that on the 14th day of July, 1975, I found evidence of the Southeast & Southwest corner of Section 6 Township 32, North, Range 8 East, Fourth, Principal Meridian, as described hereon; and that from this evidence I established a new monument and accessories as described hereon to perpetuate the original location of this corner.

Resident witnesses:

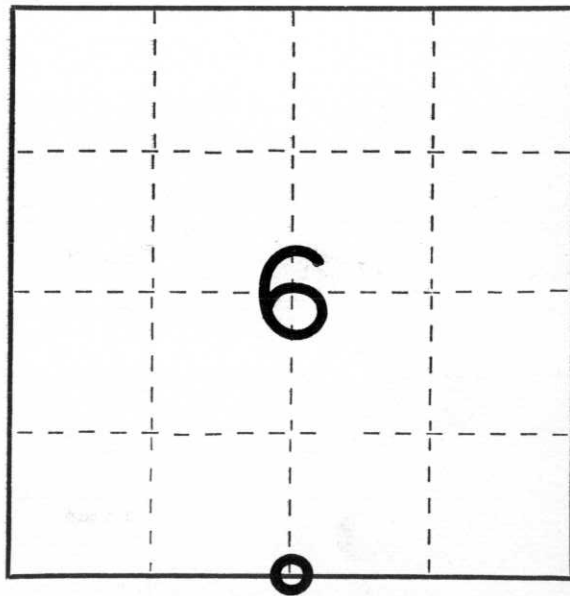

○ = Corner monument restored.

History of original corner establishment:

Surveyor: A.G. & F.S. Ellis
Date: 2 April 1852
Monumentation: Wood Post
Witnesses: Birch 10 N 30° E 15 links
Birch 8 S 40° E 6 links

Description of corner evidence found: I found no evidence of the South 1/4 corner of said Section 6. Ran line from Southeast corner to Southwest corner of said Section 6, the distance being 5,453.61'. Original distance called for 5,436.42'. The original notes called for said South 1/4 corner to be 2,640.00' west of said Southeast corner. I proportioned and set said South 1/4 corner at 2,648.35' west of said Southeast corner.

Description of monument and accessories I established to perpetuate the original location of this corner.

Berntsen Monument - 30" (set 5" below the surface of the Town Road)

P.K. Nail in 10" Norway Pine N 27° E, 81.68'
P.K. Nail in 12" Norway Pine S 22° E, 161.23'
1" dia. Iron Pipe S 6° W, 21.52'
1" dia. Iron pipe N 1° W, 28.94'

Dated at Rhineland, Wis., this 15th day of November, 1975.

Signature Lester J. Schmit Title Land Surveyor Registration No. S-1192
(County Surveyor, Registered Land Surveyor, or other duly authorized official)

Office of Register of Deeds, County of _____, I hereby certify that the within instrument was filed in this office for record on the _____ day of _____, 19____ at _____ o'clock _____ M.

(Register of Deeds)

By _____ Deputy