

CERTIFIED LAND CORNER RESTORATION

Index No. C-5

State of Wisconsin }
County of Lincoln } ss.

History of original corner establishment: Surveyor: A.G. & F.S. Ellis Date: 2 April 1852

Monumentation: Wood Post

Witnesses: Birch 7 N 67° E 19 links
Birch 10 N 57° W 9 links


I, Lester J. Schmit, do hereby certify that on the 26th day of February, 1975, I found evidence of the East 1/4 corner of Section 6 Township 32, North, Range 8 East, Fourth, Principal Meridian, as described hereon; and that from this evidence I established a new monument and accessories as described hereon to perpetuate the original location of this corner.

Description of corner evidence found: A granite monument, 6" x 6" x 30", 6" above ground, set about 1912 by the Government to replace wood post. This granite monument is situated on fence lines (old) running north, south & east.

Resident witnesses:

Description of monument and accessories I established to perpetuate the original location of this corner.

- P.K. Nail in 15" Hemlock N 40° E, 101.54'
- P.K. Nail in 10" Red Maple S 53° E, 5.64'
- P.K. Nail in 18" Red Maple S 18° W, 21.65'
- P.K. Nail in 15" Sugar Maple N 7° W, 12.40'

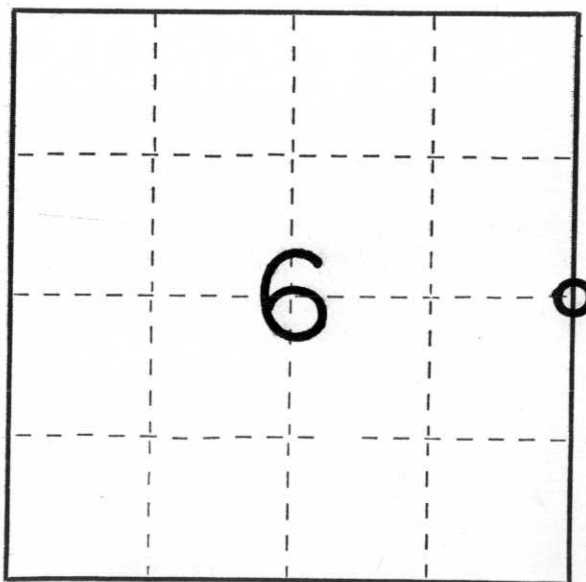

○ = Corner monument restored.

Dated at Rhineland, Wis., this 12th day of August, 1975

Signature: Lester J. Schmit Title Land Surveyor Registration No. S-1192
(County Surveyor, Registered Land Surveyor, or other duly authorized official)

Office of Register of Deeds, County of _____, I hereby certify that the within instrument was filed in this office for record on the _____ day of _____, 19____ at _____ o'clock _____ M.

(Register of Deeds)

By _____ Deputy