U.S. PUBLIC LAND SURVEY MONUMENT RECORD


This form is intended and designed to fulfill all requirements of Wisconsin Administrative Code, Chapter A-E 5.02, U.S. Public Land Survey Monument Record (3)(a)(b)(c)(d)(e)(f)(g)(h)(i). An additional sheet may be added if necessary to conform with said requirements.

(a) Corner location: Township 32 North

Range 8 East

Town/City/Village_ **SCHLEY**

LINCOLN County ____

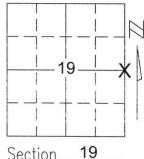


(b)(f)(g)(h) Description of monument found at this corner and if it was accepted, state all evidence (material, testimonial, occupational, plats, records, other monuments)used as a basis for accepting. If not accepted or if nothing was found, state evidence used as basis for establishing location. If reestablished through lost corner proportionate methods, indicate all monuments, distances and directions used to establish.

STONE WAS FOUND LEANING TO ONE SIDE IN THE MIDDLE OF A FOUR FENCE POST INTERSECTION. STONE WAS TIPPED BACK TO UPRIGHT POSITION WITH THE BASE OF THE STONE IN THE SAME PLACE. FILL DIRT WAS PLACED AROUND STONE FOR SUPPORT. STONE WAS TIED OUT AND BLAZES WERE MARKED ON BEARING TREES.

> RECEIVED BY LINCOLN COUNTY SURVEYOR THIS / TH

OF September 20 04 Tony Dull

(c)(d)(e) Plan view of corner with ties to at least 4 witness monuments. If in disagreement with previously established corner, show the distances between the two corners and also indicate the ties to the disputed corner.

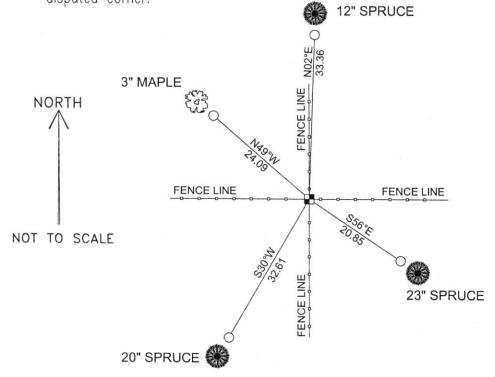

COORDINATES ARE REFERENCED TO THE LINCOLN COUNTY COORDINATE SYSTEM AS DEVELOPED BY THE WISCONSIN DEPARTMENT OF TRANSPORTATION AND WERE **DETERMINED BY GPS OBSERVATIONS** ON CONTROL POINTS AS SUPPLIED BY LINCOLN COUNTY.

BEARINGS ARE REFERENCED TO MAGNETIC NORTH.

N - 145318.858 E - 433912.964

- SET 3/4" x 30" REBAR W/ ALUM CAP AT BASE OF BEARING TREE
- EAST 1/4 CORNER

FOUND 6" x 6" GRANITE STONE

I, David A. Renaud, RLS S-2142, certify that the corner location on this record RENAUD was determined by me or under my direction and control and that this U.S. Public Land Survey Monument Record is correct and complete to the best of my knowledge and belief.

