

CERTIFIED LAND CORNER RESTORATION


Index No. 0-9

State of Wisconsin }
County of Lincoln } ss.

I Edwin R. Abendroth, do hereby certify that on the 29th day of November, 1979, I found evidence of the W 1/4 corner of Section 21 Township 32, North, Range 8 East, Fourth, Principal Meridian, as described hereon; and that from this evidence I established a new monument and accessories as described hereon to perpetuate the original location of this corner.

Resident witnesses:

Donald R. Krueger
Town Chairman (Salley)

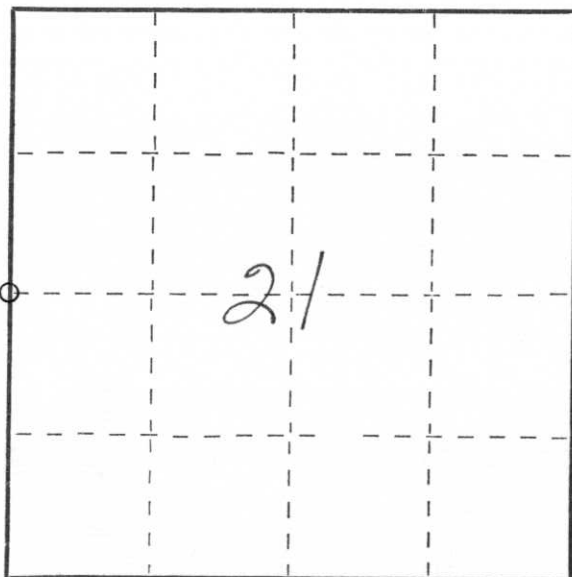


○ = Corner monument restored.

History of original corner establishment:
1/4 Section post set & witness trees, referenced in original Government Survey. No later history of corner discovered.

Description of corner evidence found:
No original evidence found
8"X8" Granite Stone located by Town Chairman & Supervisors (See resident sig.)

Description of monument and accessories I established to perpetuate the original location of this corner.
See Sketch

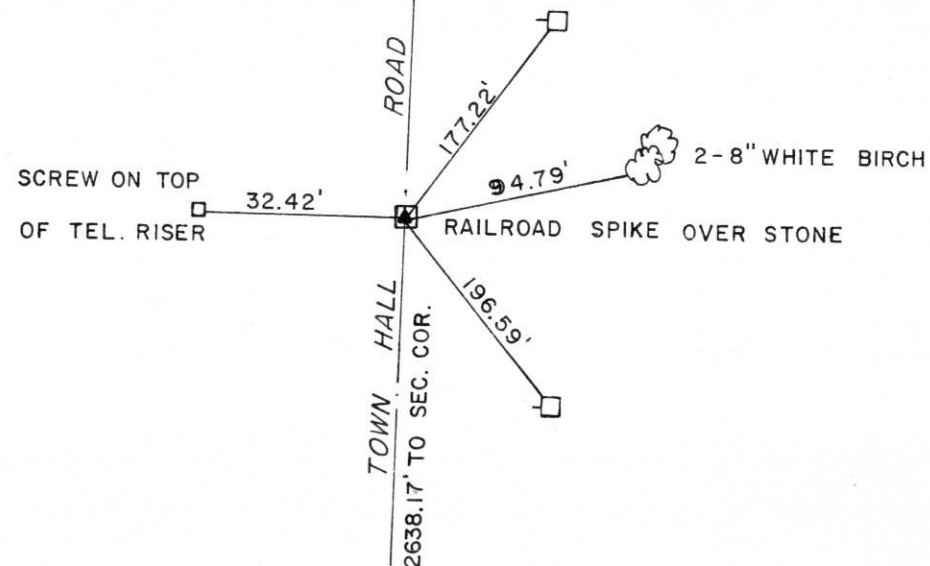

Dated at Wausau, Wis., this 29th day of November, 1979.

Signature Edwin R. Abendroth Title R.L.S. Registration No. S-798
(County Surveyor, Registered Land Surveyor, or other duly authorized official)

Office of Register of Deeds, County of _____, I hereby certify that the within instrument was filed in this office for record on the _____ day of _____, 19____ at _____ o'clock _____ M.

(Register of Deeds)

By _____ Deputy