

CERTIFIED LAND CORNER RESTORATION

Index No. 0-13

State of Wisconsin }  
County of Lincoln } ss.

I Edwin R. Abendroth  
do hereby  
certify that on the 9th day  
of May 19.85, I found  
evidence of the West 1/4  
corner of Section 22  
Township 32, North, Range  
8 East, Fourth, Principal Meridian,  
as described hereon; and that from this evidence  
I established a new monument and accessories  
as described hereon to perpetuate the original  
location of this corner.

Resident witnesses:

Pat Ryan



History of original corner establishment:

Wood post set by original Government survey

Description of corner evidence found:

Found 8" X 8" Granite stone with bottom part of cedar post along side removed cedar post and brought to County Surveyor's Office. Set iron pipe to aid in location.

Description of monument and accessories I established to perpetuate the original location of this corner.

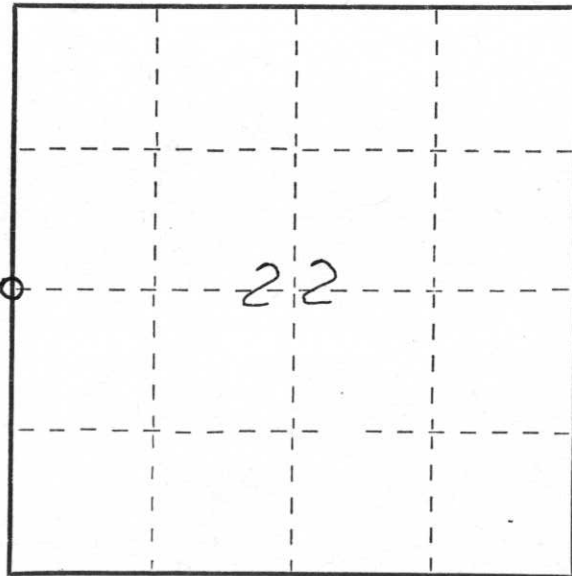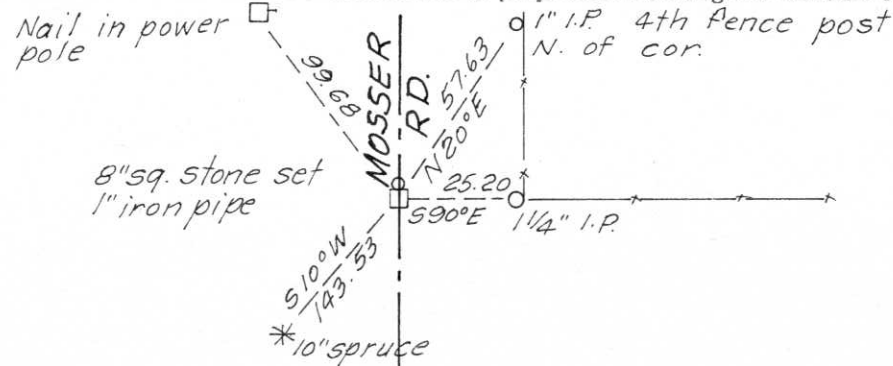

○ = Corner monument restored.

Dated at Wausau, Wis., this 13th day of May 19 85

Signature Edwin R. Abendroth Title Surveyor Registration No. S-798  
(County Surveyor, Registered Land Surveyor, or other duly authorized official)

Office of Register of Deeds, County of \_\_\_\_\_, I hereby certify that the within instrument was filed in this office for record on the \_\_\_\_\_ day of \_\_\_\_\_, 19 \_\_\_\_\_ at \_\_\_\_\_ o'clock \_\_\_\_\_ M.

(Register of Deeds)

By \_\_\_\_\_ Deputy