## U.S. PUBLIC LAND SURVEY MONUMENT RECORD

Note: This form is intended and designed to fulfill all requirements of Wisconsin Administrative Code, Chapter A-E 7.08 U.S.

Public Land Survey Monument Record (3)(a)(b)(c)(d)(e)(f)(g)(h)(i). An additional sheet may be added if necessary to conform with said requirements.

(a) Corner location: Township 32 North

Town/City/Village SCHLE Y
County LINCOLN

Section 23

(b) (f) (g) (h) Description of monument found at this corner and if it was accepted, state all evidence (material, testimonial, occupational, plats, records, other monuments)used as a basis for accepting. If not accepted or if nothing was found, state evidence used as basis for establishing location. If reestablished through lost corner proportionate methods, indicate all monuments, distances and directions used to establish. Indicate type of monument found or set and sign post.


-1800'S- GOV'T. SET WOOD POST

-2001- KEVIN BIXBY FOUND 6" X 6" GRANITE MONUMENT AND WITNESSED AS SHOWN BELOW

(c) (d) (e) Plan view of corner with ties to at least 4 witness monuments. If in disagreement with previously established corner, show the distances between the two corners and also indicate the ties to the disputed corner.

LEGEND

(A)

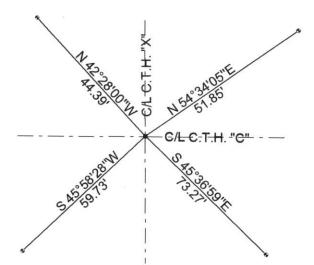

- FOLIND

- FOUND 6" X 6" GRANITE MONUMENT
- SET L.C.W.M. (3/4" X 30" IRON PIPE)

NOTE: BEARINGS AND DISTANCES MEASURED WITH A TOTAL STATION.

RECEIVED AT LINCOLN COUNTY
COURTHOUSE THIS 27 TH DAY

Day Dashim
LAND INFORMATION OFFICE

(i) I. KEVIN P. BIXBY

(type or print name) certify that the corner location on this record was determined by me or under my direction and control and that this U.S. Public Land Survey Monument Record is correct and complete to the best of my knowledge and belief.

K. P. B. Hby
Signature

12/26/01



Index No. Q 11

Stamp