

# LINCOLN COUNTY U.S. PUBLIC LAND TIE SHEET RECORD

SECTION 10  
TOWNSHIP 33N  
RANGE 4 E

103348  
NO.

LANDMARK


**CORNING**  
CITY, VILLAGE, TOWN

CORNER INDENTITY: AXLE

LINCOLN COUNTY COORDINATE: N: 185380.131  
E: 322282.449

DATE OF SURVEY: October 23, 2008  
SURVEY PARTY: Eron

FOUND   
SET   
RE-SET   
RE-TIED

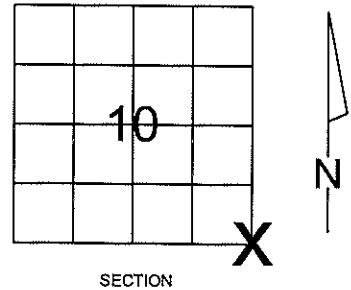


Description of monument found at this corner and if was accepted, state all evidence (material, testimonial, occupational, plats, records, other monuments) used as a basis for accepting. If not accepted or if nothing was found, state evidence used as basis for establishing location. If reestablished through lost corner proportionate methods, indicate all monuments, distances and directions used to establish.

## BASIS FOR MONUMENT LOCATION:

(DESCRIBE METHOD OF SURVEY AND CORNER AUTHENTICATION)

Survey by Joseph S. Kroeninger, dated April 12, 1982, indicated he found, but did not accept, an axle. Mr. Kroeninger had set an iron pipe at his location of the corner, which was found. Based on Mr. Kroeninger's survey, the axle he found was compared to the original notes. Based on these comparisons along with testimonial evidence, and the fact that Mr. Kroeninger's iron pipe was improperly set, the axle location was held as the corner.

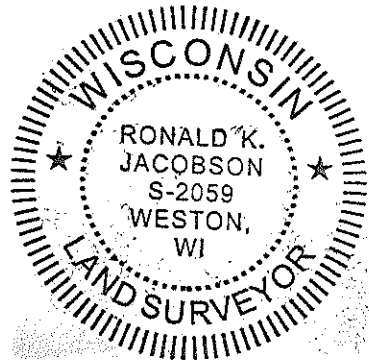

**CWE, Inc.**

5707 SCHOFIELD AVE.  
WESTON, WISCONSIN  
54476

PHONE: (715) 359-9400  
FAX: (715) 355-4199

general@cwengineers.com  
www.cwengineers.com

RECEIVED BY LINCOLN COUNTY  
SURVEYOR THIS 24<sup>TH</sup> DAY  
OF October, 20 08  
Jerry Dault  
COUNTY SURVEYOR

CERTIFIED CORRECT:


Ronald Jacobson  
Ronald Jacobson RLS 2059-008

Registered Land Surveyor

DATE: October 24, 2008

## TIE SKETCH:

SHOW MINIMUM OF FOUR (4) HORIZONTAL TIE DISTANCES TO FIXED WITNESS MONUMENTS.  
DESCRIBE ALL MONUMENTS FOUND OR SET. ALL DISTANCES SHOWN IN US SURVEY FEET.

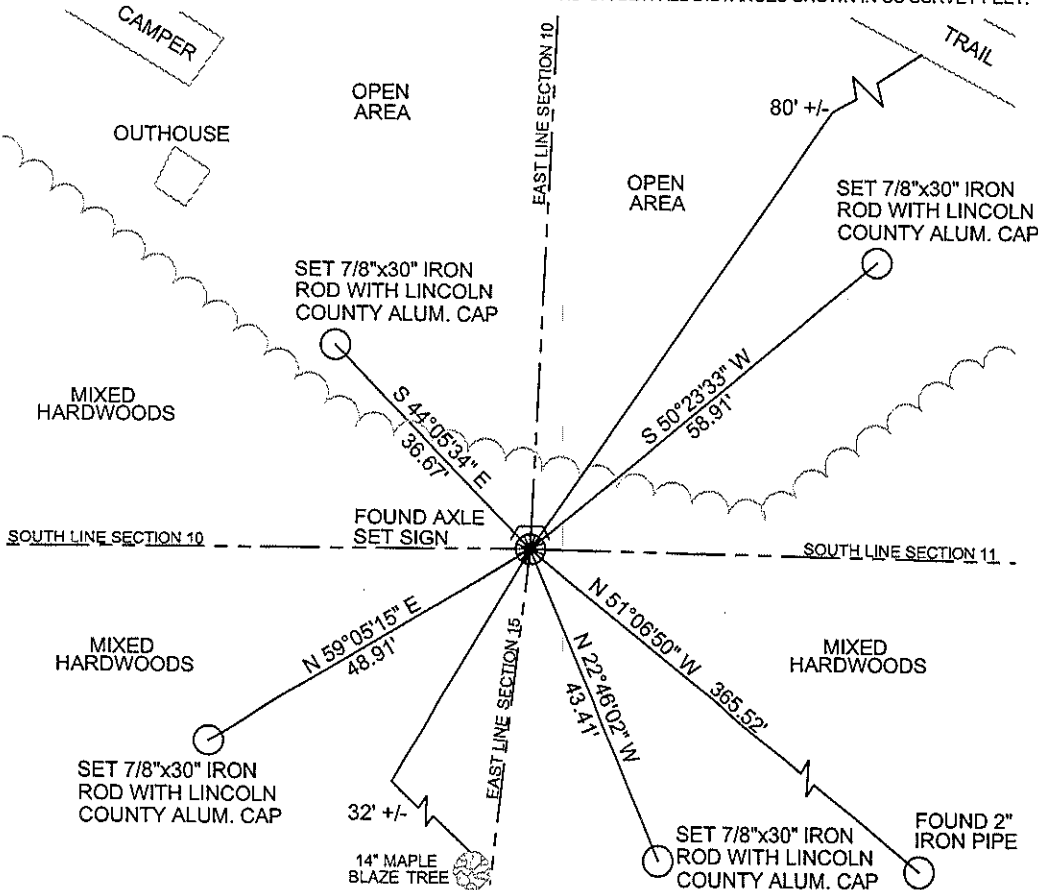

COORDINATES ARE REFERENCED TO LINCOLN COUNTY COORDINATE SYSTEM AS DEVELOPED BY THE WI. DEPARTMENT OF TRANSPORTATION AND ARE BASED ON GPS OBSERVATIONS TO CONTROL POINTS AS SUPPLIED BY LINCOLN COUNTY.



NOT TO SCALE  
BEARINGS REFERENCED  
TO LINCOLN COUNTY  
COORDINATE SYSTEM

1-17



Picture 3 – Looking South From Corner



Picture 4 – Looking West From Corner



Picture 5 –Found Axel and Set Sign at Corner

