

# LINCOLN COUNTY U.S. PUBLIC LAND TIE SHEET RECORD

SECTION 13  
TOWNSHIP 33N  
RANGE 4 E

13344  
NO.

**CORNING**

CITY, VILLAGE, TOWN




CORNER IDENTIFY: BERNSTEN MONUMENT

LINCOLN COUNTY COORDINATE: N: 182691.782  
E: 327545.058

DATE OF SURVEY: November 5, 2008  
SURVEY PARTY: Eron

- FOUND
- SET
- RE-SET
- RE-TIED

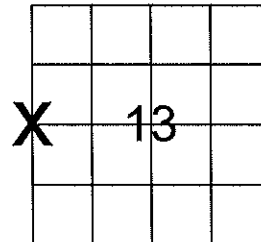

SECTION

Description of monument found at this corner and if was accepted, state all evidence (material, testimonial, occupational, plats, records, other monuments) used as a basis for accepting. If not accepted or if nothing was found, state evidence used as basis for establishing location. If reestablished through lost corner proportionate methods, indicate all monuments, distances and directions used to establish.

## BASIS FOR MONUMENT LOCATION:

(DESCRIBE METHOD OF SURVEY AND CORNER AUTHENTICATION)

Set Lincoln County Bernsten Monument at Corner. No evidence of the corner remained. A painted yellow line exists to the north. Bernsten Monument was set using single proportion measurement method.




**CWE, Inc.**

5707 SCHOFIELD AVE.  
WESTON, WISCONSIN  
54476

PHONE: (715) 359-9400  
FAX: (715) 355-4199

general@cwengineers.com  
www.cwengineers.com

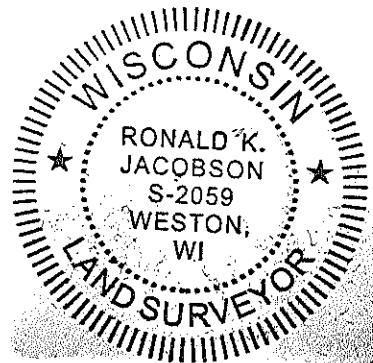

CERTIFIED CORRECT:

*Ronald K. Jacobson*


Ronald Jacobson RLS 2059-008

Registered Land Surveyor

DATE: November 7, 2008


## TIE SKETCH:

SHOW MINIMUM OF FOUR (4) HORIZONTAL TIE DISTANCES TO FIXED WITNESS MONUMENTS.  
DESCRIBE ALL MONUMENTS FOUND OR SET. ALL DISTANCES SHOWN IN US SURVEY FEET.

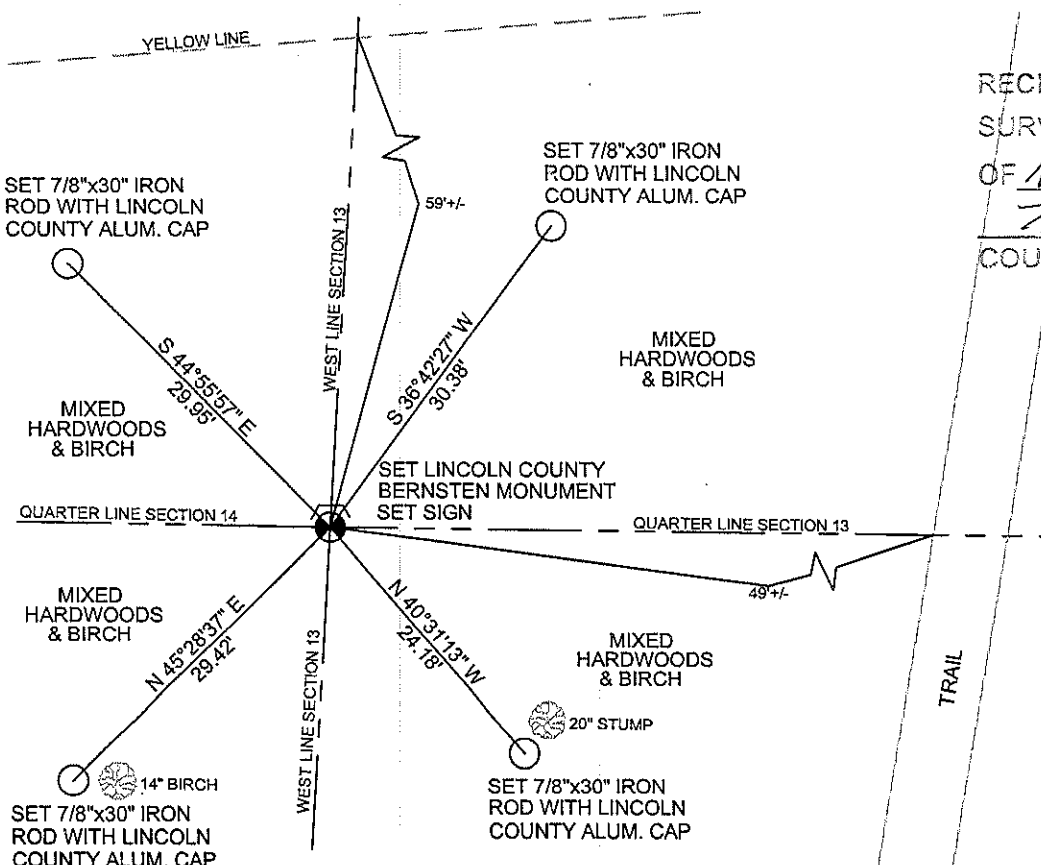

RECEIVED BY LINCOLN COUNTY  
SURVEYOR THIS 7<sup>TH</sup> DAY  
OF November 20 08  
*Tony Dallen*  
COUNTY SURVEYOR

COORDINATES ARE REFERENCED TO LINCOLN COUNTY COORDINATE SYSTEM AS DEVELOPED BY THE WI. DEPARTMENT OF TRANSPORTATION AND ARE BASED ON GPS OBSERVATIONS TO CONTROL POINTS AS SUPPLIED BY LINCOLN COUNTY.

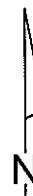

NOT TO SCALE  
BEARINGS REFERENCED  
TO LINCOLN COUNTY  
COORDINATE SYSTEM

K-21

Picture 1 – Looking North From Corner



Picture 2 – Looking East From Corner



Picture 3 – Looking South From Corner



Picture 4 – Looking West From Corner



Picture 5 –Set Lincoln County Berntsen Monument and Sign

