

LINCOLN COUNTY U.S. PUBLIC LAND TIE SHEET RECORD

SECTION 15
TOWNSHIP 33N
RANGE 4 E

153347



CORNING

CITY, VILLAGE, TOWN

NO.

CORNER INDENTITY: BERNSTEN MONUMENT


LINCOLN COUNTY COORDINATE: N: 180145.027

E: 318939.328

DATE OF SURVEY: November 6, 2008

SURVEY PARTY: Eron

- FOUND
- SET
- RE-SET
- RE-TIED

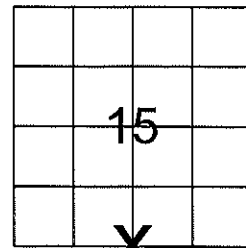

SECTION

Description of monument found at this corner and if was accepted, state all evidence (material, testimonial, occupational, plats, records, other monuments) used as a basis for accepting. If not accepted or if nothing was found, state evidence used as basis for establishing location. If reestablished through lost corner proportionate methods, indicate all monuments, distances and directions used to establish.

BASIS FOR MONUMENT LOCATION:

(DESCRIBE METHOD OF SURVEY AND CORNER AUTHENTICATION)

Set Lincoln County Bernsten Monument at Corner. Iron Pipe found to the east appeared to be based on a monument that did not represent the correct location of the Southwest Corner of Section 15. As such the Iron Pipe was not held and a Bernsten Monument was set using single proportion measurement method.




CWE, Inc.

5707 SCHOFIELD AVE.
WESTON, WISCONSIN
54476

PHONE: (715) 359-9400
FAX: (715) 355-4199

general@cwengineers.com
www.cwengineers.com

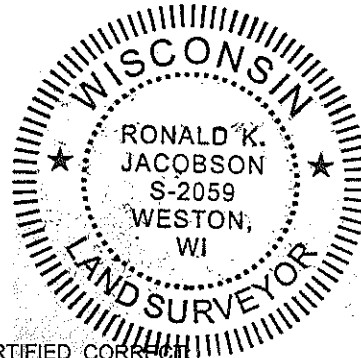

CERTIFIED CORRECT


Ronald K. Jacobson
Ronald Jacobson RLS 2059-008

Registered Land Surveyor

DATE: November 7, 2008


TIE SKETCH:

SHOW MINIMUM OF FOUR (4) HORIZONTAL TIE DISTANCES TO FIXED WITNESS MONUMENTS.
DESCRIBE ALL MONUMENTS FOUND OR SET. ALL DISTANCES SHOWN IN US SURVEY FEET.

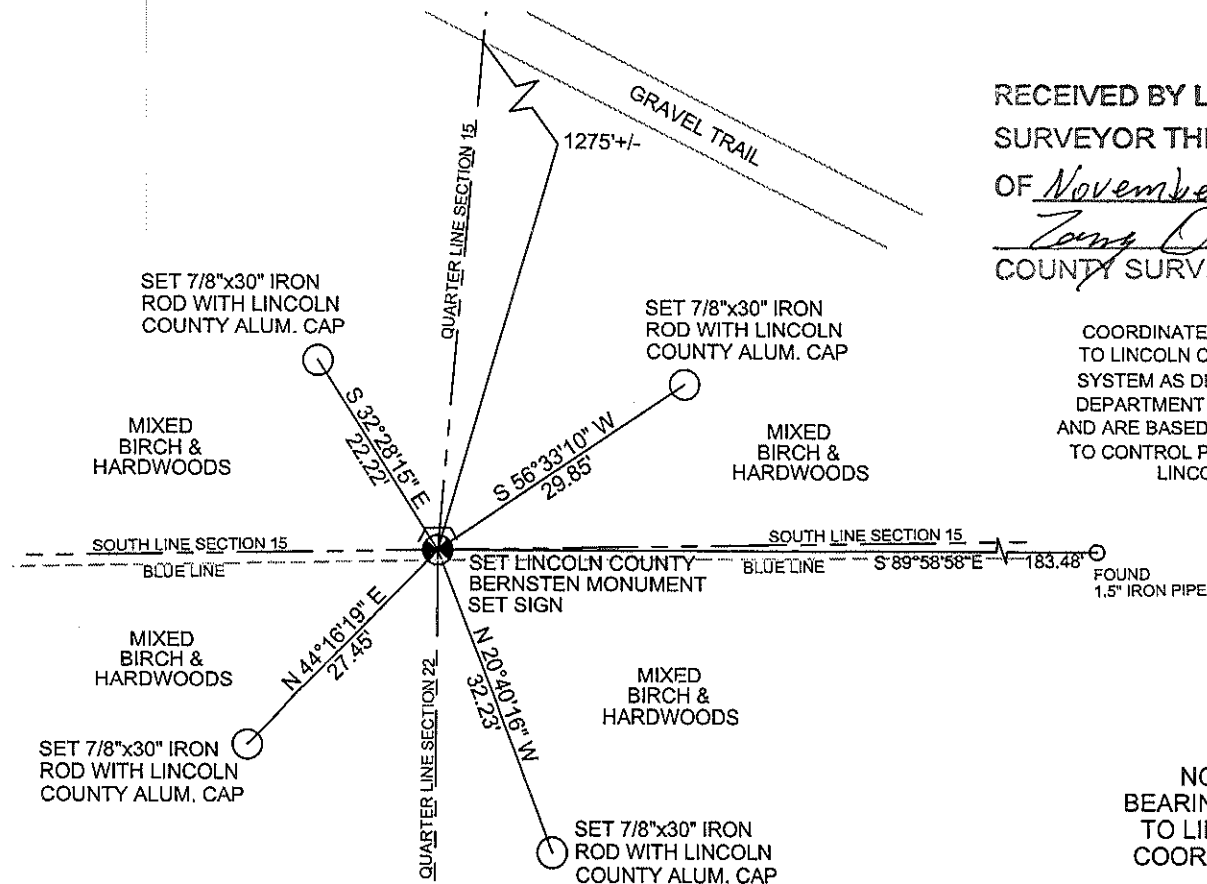

RECEIVED BY LINCOLN COUNTY
SURVEYOR THIS 7TH DAY
OF November 2008
Tommy Oak
COUNTY SURVEYOR

COORDINATES ARE REFERENCED
TO LINCOLN COUNTY COORDINATE
SYSTEM AS DEVELOPED BY THE WI.
DEPARTMENT OF TRANSPORTATION
AND ARE BASED ON GPS OBSERVATIONS
TO CONTROL POINTS AS SUPPLIED BY
LINCOLN COUNTY.

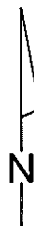

NOT TO SCALE
BEARINGS REFERENCED
TO LINCOLN COUNTY
COORDINATE SYSTEM

M-15

Picture 1 – Looking North From Corner



Picture 2 – Looking East From Corner



Picture 3 – Looking South From Corner



Picture 4 – Looking West From Corner



Picture 5 –Set Lincoln County Berntsen monument with sign

