

LINCOLN COUNTY U.S. PUBLIC LAND TIE SHEET RECORD

SECTION 20
TOWNSHIP 33N
RANGE 4 E

203344
NO.

LANDMARK


CORNING

CRPY, VILLAGE, TOWN

CORNER INDENTITY: 2.0" IRON PIPE

LINCOLN COUNTY COORDINATE: N: 177881.010
E: 305535.441

FOUND
SET
RE-SET
RE-TIED

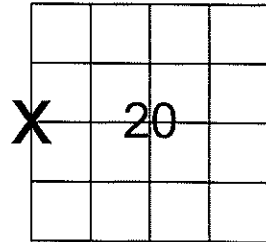


SECTION

Description of monument found at this corner and if was accepted, state all evidence (material, testimonial, occupational, plats, records, other monuments) used as a basis for accepting. If not accepted or if nothing was found, state evidence used as basis for establishing location. If reestablished through lost corner proportionate methods, indicate all monuments, distances and directions used to establish.

BASIS FOR MONUMENT LOCATION:

(DESCRIBE METHOD OF SURVEY AND CORNER AUTHENTICATION)

Found 2.0" Iron Pipe, a 1.0" Iron Pipe and Wood Post at Corner. Property evidence, Bearing Tree and comparison to Owens Illinois Notes dated 5-17-74 and the original notes supports the 2.0" Iron Pipe as corner.

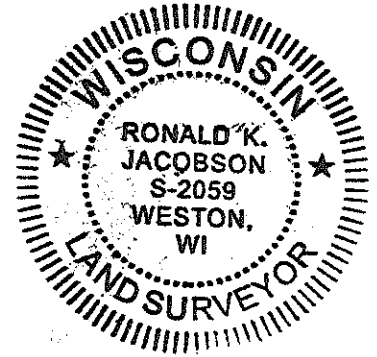

CWE, Inc.

5707 SCHOFIELD AVE.
WESTON, WISCONSIN
54476

PHONE: (715) 359-9400
FAX: (715) 355-4199

general@cwengineers.com
www.cwengineers.com

RECEIVED BY LINCOLN COUNTY
SURVEYOR THIS 29TH DAY
OF August 20 08
Ronald Jacobson
COUNTY SURVEYOR

CERTIFIED CORRECT:

Ronald Jacobson


Ronald Jacobson RLS 2059-008

Registered Land Surveyor

DATE: AUGUST 28, 2008

TIE SKETCH:

SHOW MINIMUM OF FOUR (4) HORIZONTAL TIE DISTANCES TO FIXED WITNESS MONUMENTS.
DESCRIBE ALL MONUMENTS FOUND OR SET. ALL DISTANCES SHOWN IN US SURVEY FEET.

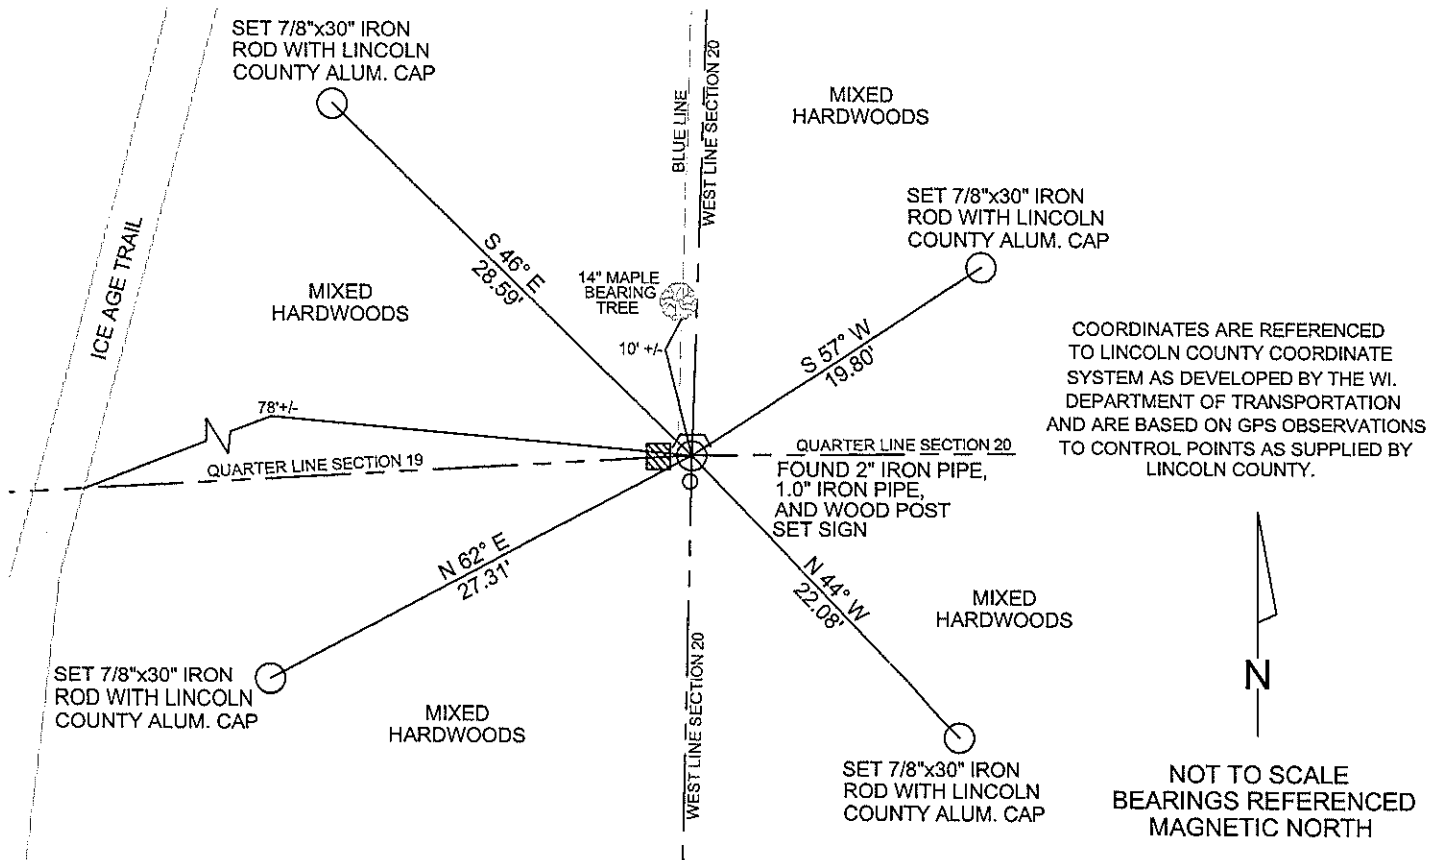

0-5

Picture 3 – Looking South From Corner



Picture 4 – Looking West From Corner



Picture 5 –Found 2.0" IP, 1.0" IP, and Wood Post

