

LINCOLN COUNTY U.S. PUBLIC LAND TIE SHEET RECORD

SECTION 26
TOWNSHIP 33N
RANGE 4 E

263342
NO.

LANDMARK


CORNING
CITY, VILLAGE, TOWN

CORNER INDENTITY: SWAMP MONUMENT

LINCOLN COUNTY COORDINATE: N: 174331.725
E: 324615.630

DATE OF SURVEY: November 19, 2008
SURVEY PARTY: Eron

FOUND
SET
RE-SET
RE-TIED

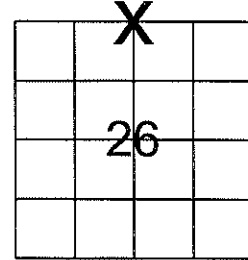


SECTION

Description of monument found at this corner and if was accepted, state all evidence (material, testimonial, occupational, plats, records, other monuments) used as a basis for accepting. If not accepted or if nothing was found, state evidence used as basis for establishing location. If reestablished through lost corner proportionate methods, indicate all monuments, distances and directions used to establish.

BASIS FOR MONUMENT LOCATION:

(DESCRIBE METHOD OF SURVEY AND CORNER AUTHENTICATION)

Set Lincoln County Swamp Monument at Corner. No evidence of the corner remained. Swamp Monument was set using single proportion measurement method.

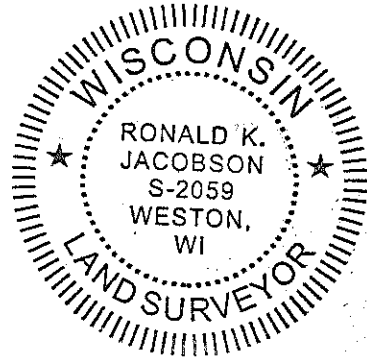

CWE, Inc.

5707 SCHOFIELD AVE.
WESTON, WISCONSIN
54476

PHONE: (715) 359-9400
FAX: (715) 355-4199

general@cwengineers.com
www.cwengineers.com

RECEIVED BY LINCOLN COUNTY
SURVEYOR THIS 26TH DAY
OF November 20 08
Ronald Jacobson
COUNTY SURVEYOR

CERTIFIED CORRECT:


Ronald Jacobson
Registered Land Surveyor
RLS 2059-008

DATE: November 24, 2008


TIE SKETCH:

SET 7/8"x30" IRON
ROD WITH LINCOLN
COUNTY ALUM. CAP

SHOW MINIMUM OF FOUR (4) HORIZONTAL TIE DISTANCES TO FIXED WITNESS MONUMENTS.
DESCRIBE ALL MONUMENTS FOUND OR SET. ALL DISTANCES SHOWN IN US SURVEY FEET.

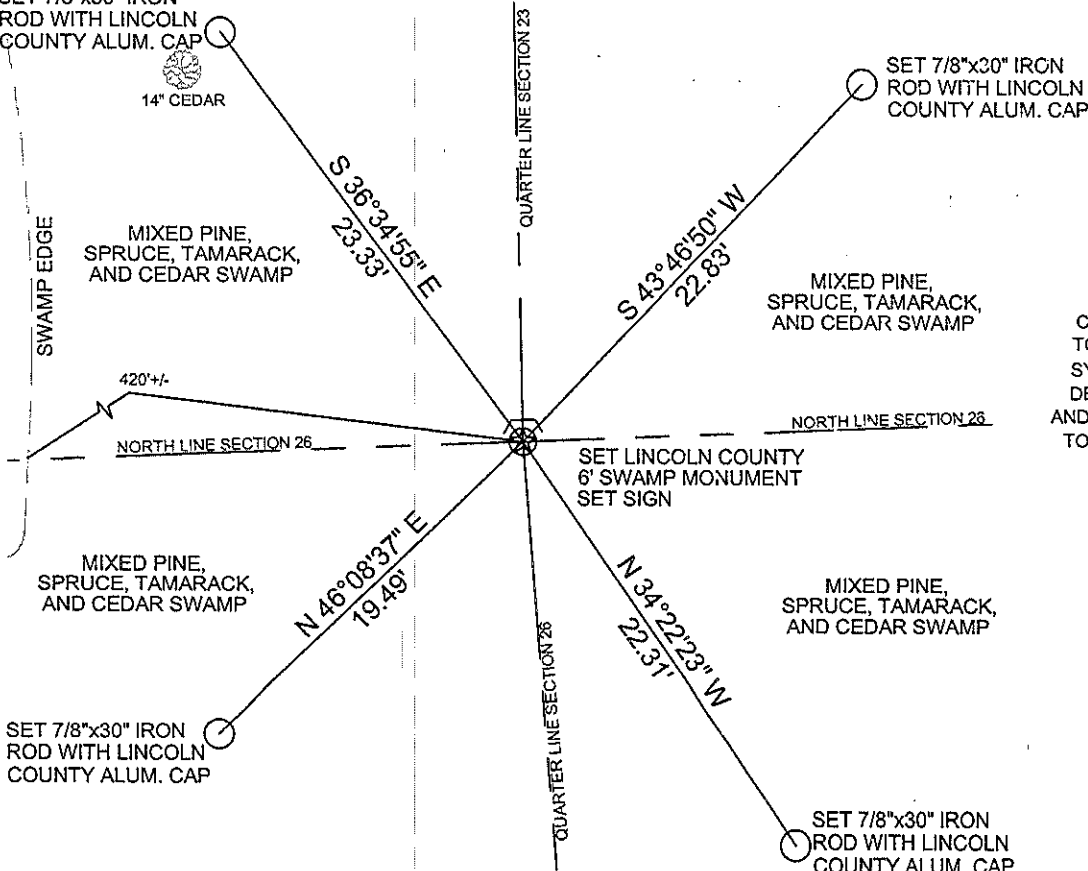

COORDINATES ARE REFERENCED
TO LINCOLN COUNTY COORDINATE
SYSTEM AS DEVELOPED BY THE WI.
DEPARTMENT OF TRANSPORTATION
AND ARE BASED ON GPS OBSERVATIONS
TO CONTROL POINTS AS SUPPLIED BY
LINCOLN COUNTY.

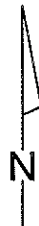

NOT TO SCALE
BEARINGS REFERENCED
TO LINCOLN COUNTY
COORDINATE SYSTEM

Picture 1 – Looking North From Corner




Picture 2 – Looking East From Corner



Picture 3 – Looking South From Corner



Picture 4 – Looking West From Corner

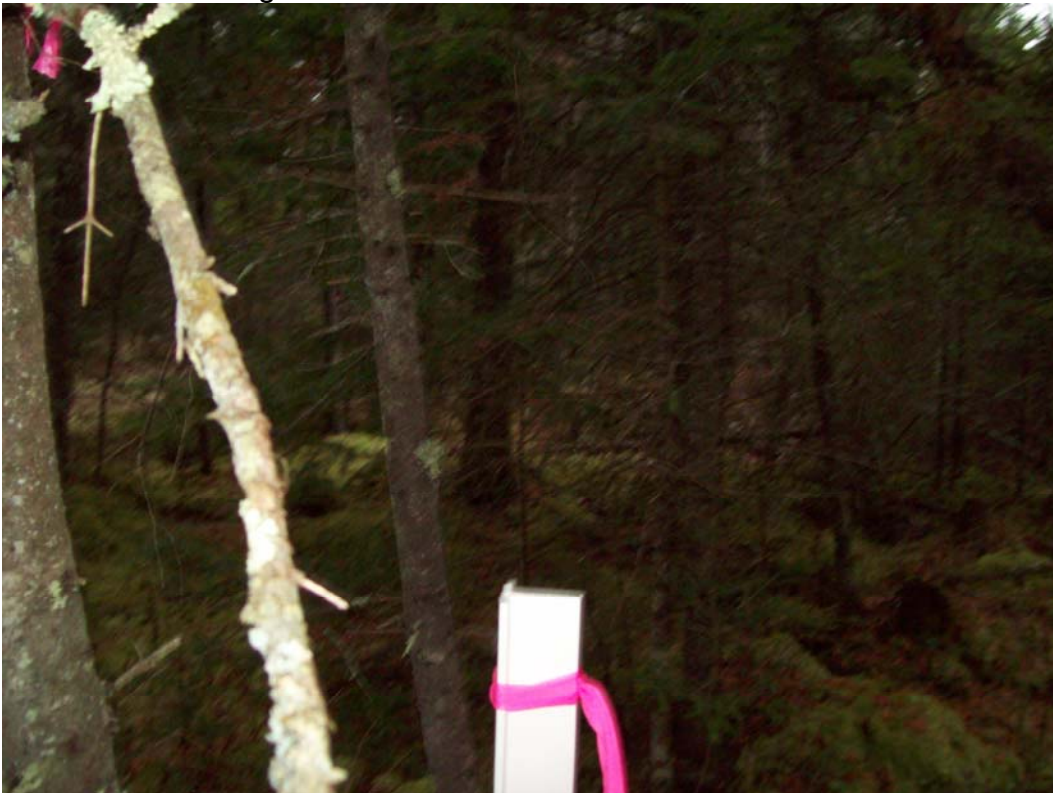

Picture 5 –Set Swamp Monument and Sign at Corner

