

LINCOLN COUNTY U.S. PUBLIC LAND TIE SHEET RECORD

SECTION 26
TOWNSHIP 33N
RANGE 4 E

263344



LANDMARK

CORNING

CITY, VILLAGE, TOWN

NO.

CORNER INDENTITY: BERNSTEN MONUMENT



LINCOLN COUNTY COORDINATE: N: 171709.959

E: 322000.585

DATE OF SURVEY: August 27, 2008

SURVEY PARTY: Eron

FOUND
SET
RE-SET
RE-TIED

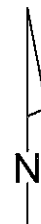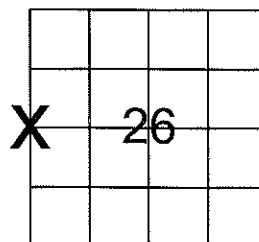


SECTION

Description of monument found at this corner and if was accepted, state all evidence (material, testimonial, occupational, plats, records, other monuments) used as a basis for accepting. If not accepted or if nothing was found, state evidence used as basis for establishing location. If reestablished through lost corner proportionate methods, indicate all monuments, distances and directions used to establish.

BASIS FOR MONUMENT LOCATION:

(DESCRIBE METHOD OF SURVEY AND CORNER AUTHENTICATION)

Set Lincoln County Bernsten Monument at Corner. 1.5" Iron Pipe was not held since it did not agree with the original notes and there was no evidence found on how it was established. No other evidence as to the location of the corner was found. Bernsten Monument was set using single proportion measurement method.

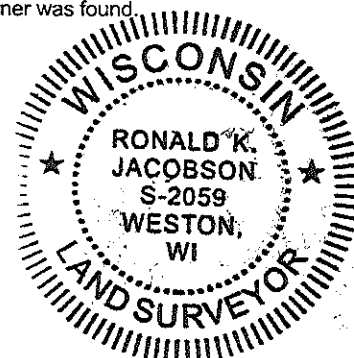

CERTIFIED CORRECT:

Ronald Jacobson

Ronald Jacobson RLS 2059-008

Registered Land Surveyor

DATE: AUGUST 28, 2008



CWE, Inc.


5707 SCHOFIELD AVE.
WESTON, WISCONSIN
54476

PHONE: (715) 359-9400
FAX: (715) 355-4199

general@cwengineers.com
www.cwengineers.com


TIE SKETCH:

SHOW MINIMUM OF FOUR (4) HORIZONTAL TIE DISTANCES TO FIXED WITNESS MONUMENTS.
DESCRIBE ALL MONUMENTS FOUND OR SET. ALL DISTANCES SHOWN IN US SURVEY FEET.

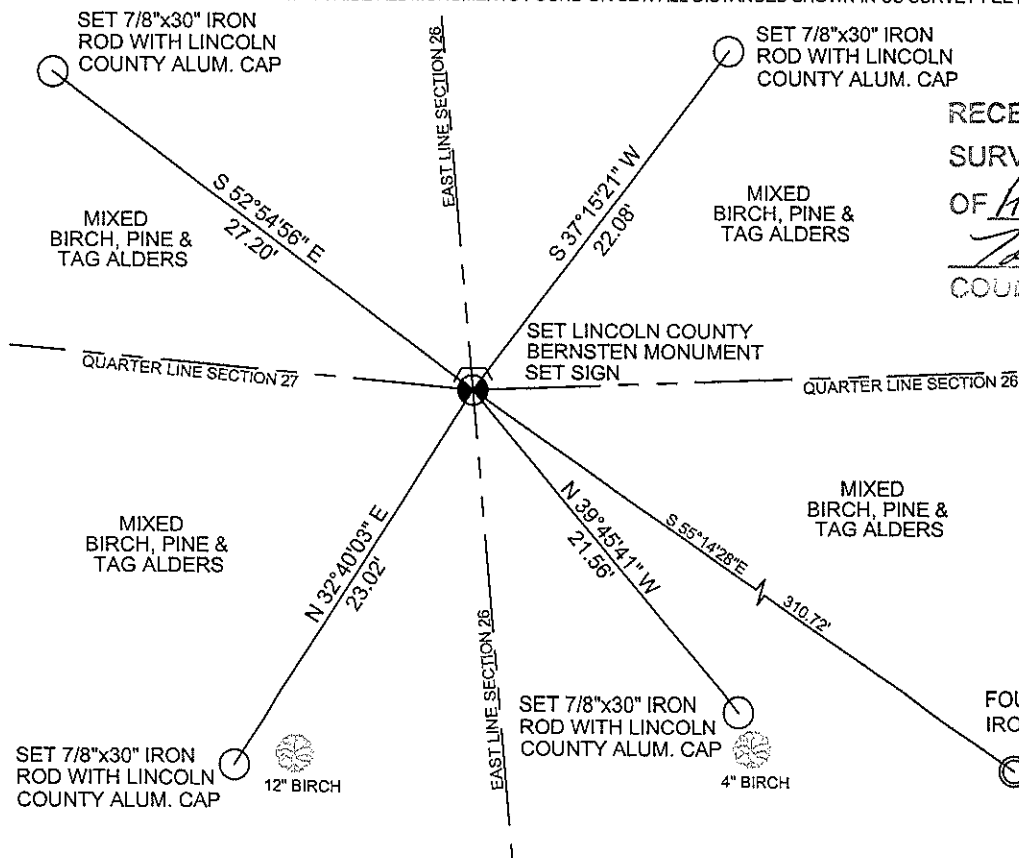

RECEIVED BY LINCOLN COUNTY
SURVEYOR THIS 29TH DAY
OF August 2008
Tony Dahr
COUNTY SURVEYOR

COORDINATES ARE REFERENCED TO LINCOLN COUNTY COORDINATE SYSTEM AS DEVELOPED BY THE WI. DEPARTMENT OF TRANSPORTATION AND ARE BASED ON GPS OBSERVATIONS TO CONTROL POINTS AS SUPPLIED BY LINCOLN COUNTY.

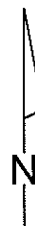

NOT TO SCALE
BEARINGS REFERENCED
LINCOLN COUNTY
COORDINATE SYSTEM

21-5

Picture 1 – Looking North From Corner



Picture 2 – Looking East From Corner



Picture 3 – Looking South From Corner



Picture 4 – Looking West From Corner



Picture 5 –Set Bernstein Monument



Picture 5 –Found 1.5" Iron Pipe to the Southeast



