

LINCOLN COUNTY U.S. PUBLIC LAND TIE SHEET RECORD

SECTION 29
TOWNSHIP 33N
RANGE 4 E

293345
NO.

LANDMARK

CORNING


CITY, VILLAGE, TOWN

CORNER INDENTITY: BERNSTEN MONUMENT

LINCOLN COUNTY COORDINATE: N: 172643.502
E: 310934.252

DATE OF SURVEY: June 25, 2008
SURVEY PARTY: Eron/Rutzen

FOUND
SET
RE-SET
RE-TIED

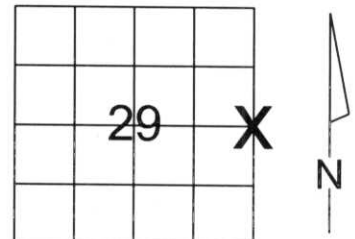

SECTION

Description of monument found at this corner and if was accepted, state all evidence (material, testimonial, occupational, plats, records, other monuments) used as a basis for accepting. If not accepted or if nothing was found, state evidence used as basis for establishing location. If reestablished through lost corner proportionate methods, indicate all monuments, distances and directions used to establish.

BASIS FOR MONUMENT LOCATION:

(DESCRIBE METHOD OF SURVEY AND CORNER AUTHENTICATION)
Set Lincoln County Bernsten Monument at Corner. Found 2.0 Iron Pipe with wood post 193 feet to the west. Did not hold the location of this corner due to discrepancies found in how it was established. Bernsten Monument was set using single proportion measurement method. Blue lines support the location of the Bernsten Monument.



CERTIFIED CORRECT:

[Signature]

Ronald Jacobson RLS 2059-008

Registered Land Surveyor

DATE: June 27, 2008



CWE, Inc.


5707 SCHOFIELD AVE.
WESTON, WISCONSIN
54476

PHONE: (715) 359-9400
FAX: (715) 355-4199

general@cwengineers.com
www.cwengineers.com

TIE SKETCH:

SHOW MINIMUM OF FOUR (4) HORIZONTAL TIE DISTANCES TO FIXED WITNESS MONUMENTS.
DESCRIBE ALL MONUMENTS FOUND OR SET. ALL DISTANCES SHOWN IN US SURVEY FEET.

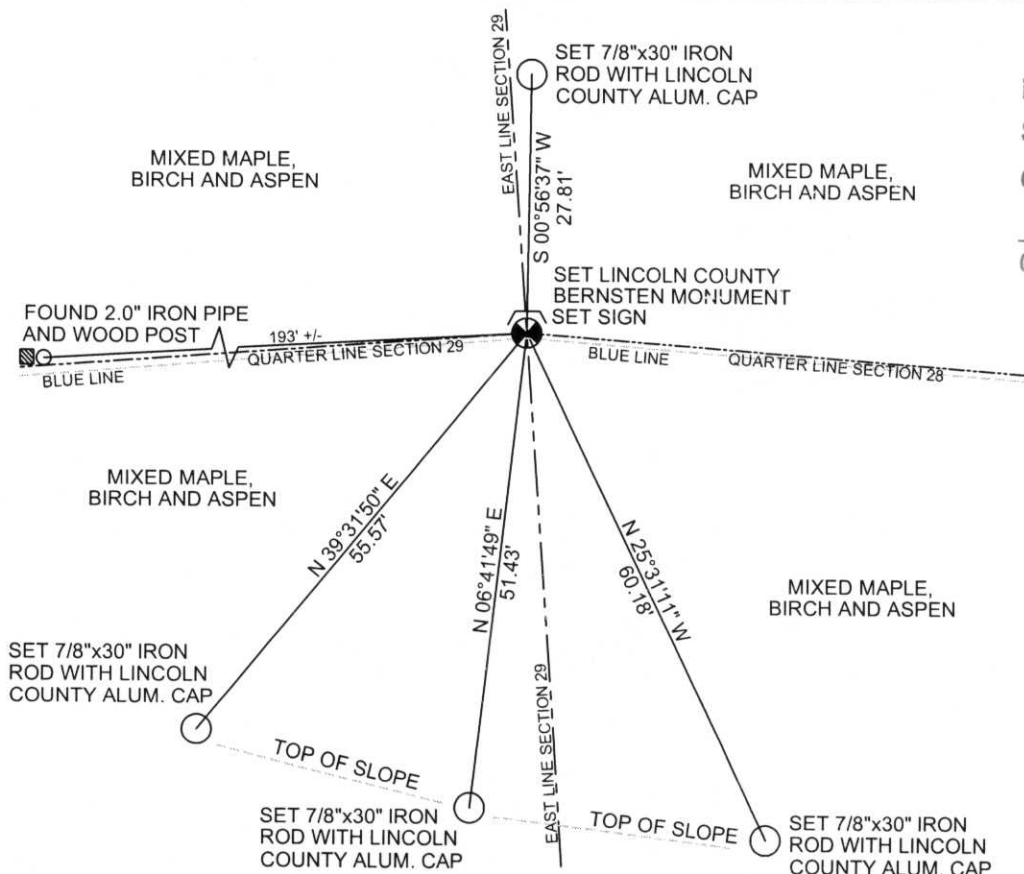

RECEIVED BY LINCOLN COUNTY
SURVEYOR THIS 27TH DAY
OF June 2008
[Signature]
COUNTY SURVEYOR

COORDINATES ARE REFERENCED TO LINCOLN COUNTY COORDINATE SYSTEM AS DEVELOPED BY THE WI. DEPARTMENT OF TRANSPORTATION AND ARE BASED ON GPS OBSERVATIONS TO CONTROL POINTS AS SUPPLIED BY LINCOLN COUNTY.


NOT TO SCALE
BEARINGS REFERENCED TO THE LINCOLN COUNTY COORDINATE SYSTEM

6-9

Picture 3 – Looking South From Corner



Picture 4 – Looking West From Corner

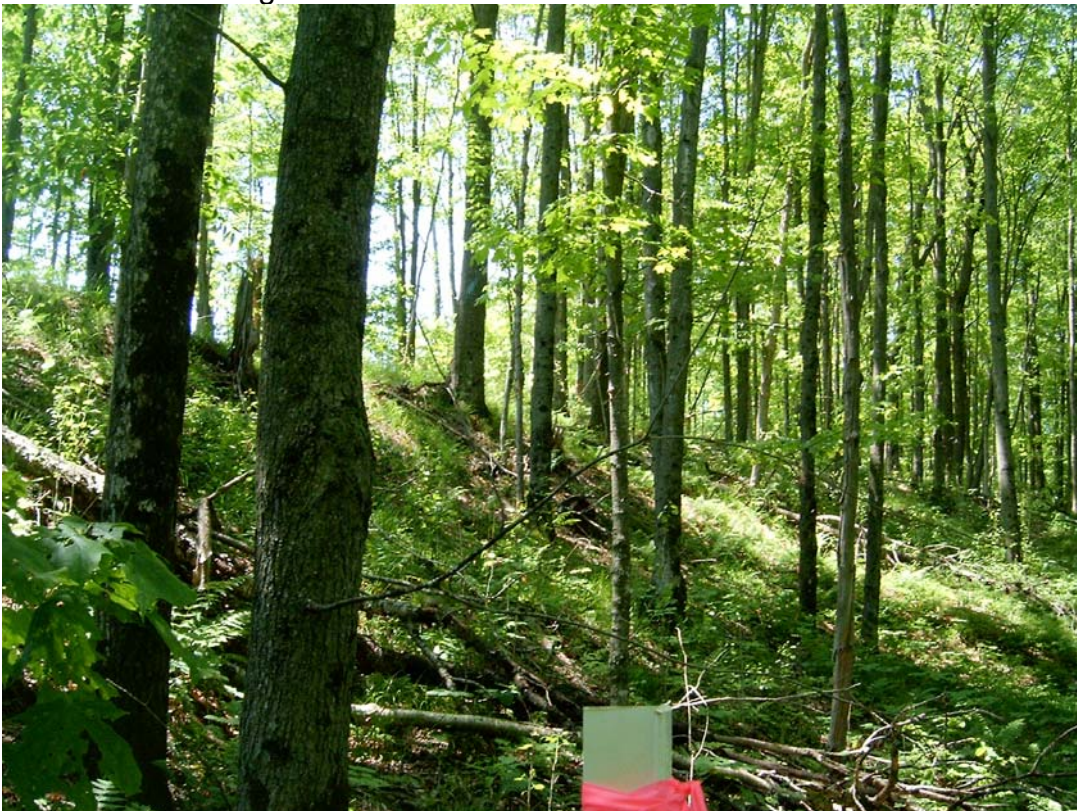

Picture 5 –Set Bernsten Monument

