


U.S. PUBLIC LAND SURVEY MONUMENT RECORD

NOTE: This form is intended and designed to fulfill all requirements of Wisconsin Administrative Code, Chapter A-E 7.08 U.S. Public Land Survey Monument Record (3)(a)(b)(c)(d)(e)(f)(g)(h)(i). An additional sheet may be added if necessary to conform with said requirements.

(a) Corner location: Township 32 North
 Range 05 East
 Town of HARDING
 LINCOLN County, Wisconsin

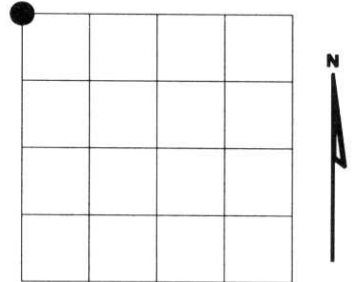

Section 06


(b)(f)(g)(h) Description of monument found at this corner and if it was accepted, state all evidence (material, testimonial, occupational, plats, records, other monuments) used as a basis for accepting. If not accepted or if nothing was found, state evidence used as basis for establishing location. If reestablished through lost corner proportionate methods, indicate all monuments, distances and directions used to establish. Indicate type of monument found or set and sign post.

1937 - FRANCIS X. FOCHS (NOW FOX) FOUND STONE MONUMENT AND ACCEPTS AS NORTH WEST CORNER OF SECTION 6. FIELD NOTES ON FILE IN LINCOLN COUNTY FOREST, LAND AND PARK DEPARTMENT.

05-01 - I FIND 6" X 6" RED GRANITE MONUMENT AND SET BEARING TREES AS SHOWN BELOW:

RECEIVED AT LINCOLN COUNTY
 COURTHOUSE THIS 8TH DAY
 OF January 20 02
Tony Dahn
 LAND INFORMATION OFFICE

(c)(d)(e) Plan view of corner with ties to at least 4 witness monuments. If in disagreement with previously established corner, show the distances between the two corners and also indicate the ties to the disputed corner.

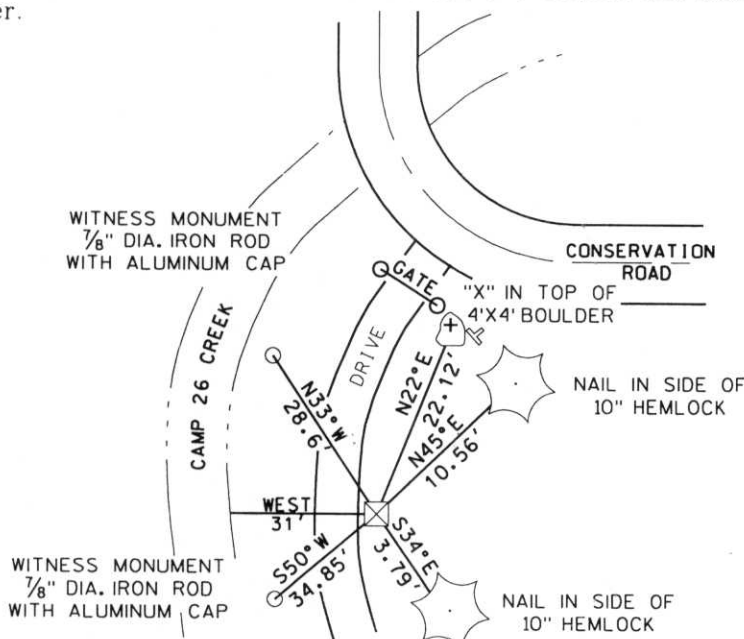

☒ = FOUND, 6" X 6" RED GRANITE MONUMENT

(i) I, EUGENE C. UTTECH, Registered Land Surveyor *S-1451, hereby certify that the corner location on this record was determined by me or under my direction and control and that this U.S. Public Land Survey Monument Record is correct and complete to the best of my knowledge and belief.



Eugene C. Uttech
 Signature

12.20.01
 Date

Index No. A-1





