

LINCOLN COUNTY U.S. PUBLIC LAND TIE SHEET RECORD

SECTION 36
TOWNSHIP 33N
RANGE 4 E

363345
NO.

LANDMARK


CORNING
CITY, VILLAGE, TOWN

CORNER INDENTITY: 6X6 GRANITE MONUMENT

LINCOLN COUNTY COORDINATE: N: 166739.390
E: 333034.298

DATE OF SURVEY: January 14, 2008
SURVEY PARTY: Eron

FOUND
SET
RE-SET
RE-TIED

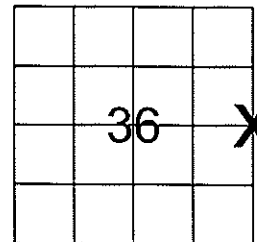


SECTION

Description of monument found at this corner and if was accepted, state all evidence (material, testimonial, occupational, plats, records, other monuments) used as a basis for accepting. If not accepted or if nothing was found, state evidence used as basis for establishing location. If reestablished through lost corner proportionate methods, indicate all monuments, distances and directions used to establish.

BASIS FOR MONUMENT LOCATION:

(DESCRIBE METHOD OF SURVEY AND CORNER AUTHENTICATION)
Found 6x6 Granite Monument at corner. Blue lines, property evidence, and comparison to the original notes supports the 6x6 Granite Monument as corner.

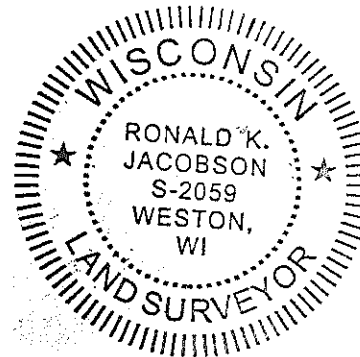

CWE, Inc.

5707 SCHOFIELD AVE.
WESTON, WISCONSIN
54476

PHONE: (715) 359-9400
FAX: (715) 355-4199

general@cwengineers.com
www.cwengineers.com

CERTIFIED CORRECT:

Ronald Jacobson


Ronald Jacobson RLS 2059-008

Registered Land Surveyor

DATE: January 25, 2008


TIE SKETCH:

SHOW MINIMUM OF FOUR (4) HORIZONTAL TIE DISTANCES TO FIXED WITNESS MONUMENTS.
DESCRIBE ALL MONUMENTS FOUND OR SET. ALL DISTANCES SHOWN IN US SURVEY FEET.

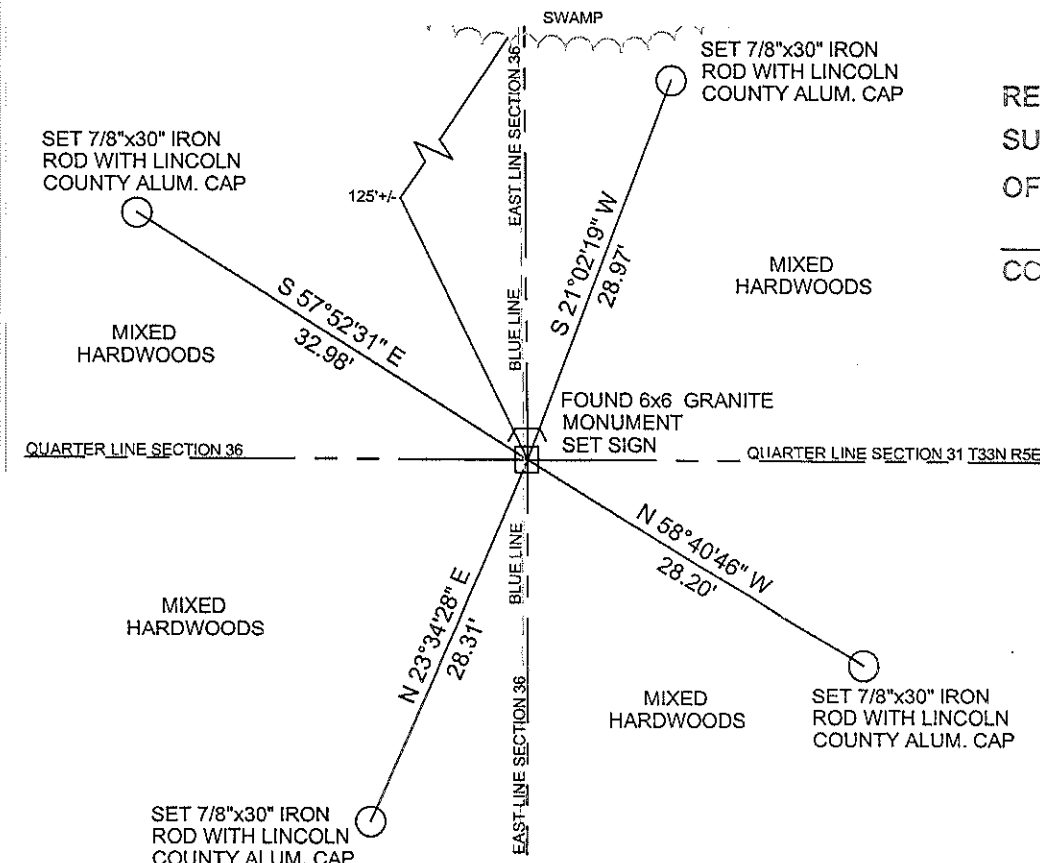

RECEIVED BY LINCOLN COUNTY
SURVEYOR THIS 24TH DAY
OF January 20 08
Tom Dull
COUNTY SURVEYOR

COORDINATES ARE REFERENCED TO LINCOLN COUNTY COORDINATE SYSTEM AS DEVELOPED BY THE WI. DEPARTMENT OF TRANSPORTATION AND ARE BASED ON GPS OBSERVATIONS TO CONTROL POINTS AS SUPPLIED BY LINCOLN COUNTY.

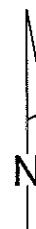

NOT TO SCALE
BEARINGS REFERENCED TO LINCOLN COUNTY COORDINATE SYSTEM

W-25

Picture 1 – Looking North From Corner at Blueline



Picture 2 – Looking East From Corner



Picture 3 – Looking South From Corner at Blueline



Picture 4 – Looking West From Corner



Picture 5 –Found 6x6 Granite Stone at Corner

