RECEIVED BY LINCOLN COUNTY
SURVEYOR THIS // THE DAY
OF November 20 04
Tomy Wall
COUNTY SURVEYOR

UMENT RECORD

we Code, Chapter A-E 7.08 U.S. Public Land Monument ith said requirements.

U.S. PUBLIC LAND SURVEY MONUMENT RECORD

Note: This form is intended and designed to fulfill all requirements of the Wisconsin Administrative Code, Chapter A-E 7.08 U.S. Public Land Monument Record (3)(a)(b)(c)(d)(e)(f)(g)(h)(i). An additional sheet may be added if necessary to confrom with said requirements.

(a) CORNER LOCATION:

COORDINATES

northeast corner of Section 36

North:

Township 33 North

East:

Range 5 East Town of Harding Control Station:

Latitude:

County of Lincoln

Longitude:

Datum Method

CTARLICUMENT

(b) HISTORY OF ORIGINAL CORNER ESTABLISHMENT

SECTION 36

Original Surveyor: J.M. Marsh

Original B.T.'S

Date of Survey: Commenced July 1851

Birch 12" dia., S25°E 31 links

Birch 12" dia., N42°W 41 links

Completed August 1851

Birch 11" dia., S28°W 47 links

Hemlock 16" dia., N12°E 41 links


(f)(g)(h) DESCRIPTION OF MONUMENT FOUND AT THIS CORNER AND IF IT WAS ACCEPTED, STATE ALL EVIDENCE (MATERIAL, TESTIMONIAL, OCCUPATIONS, PLATS, RECORDS, OTHER MONUMENTS) USED AS A BASISFOR ESTABLISHING LOCATION. IF NOT ACCEPTED OF IF NOTHING WAS FOUND, STATE EVIDENCE USED AS BASIS FOR ESTABLISHING LOCATION. IF REESTABLISHED THROUGH LOST CORNER PROPORTIONATE METHODS, INDICATE ALL MONUMENTS, DISTANCES AND DIRECTIONS USED TO ESTABLISH. INDICATE TYPE OF MONUMENT AND SIGN POST FOUND OR SET.

Original surveyor: J.M. Marsh, north 80 chains set post for corner to sections 25, 30, 31 & 36.

Francis Fox: date unknown, at 5306.95 set section corners 25, 30, 31 & 36, west 204.55', on south side of hill, south to swamp 78'. Nothing to witness, mounded high with stones.

Michael L. Oestreich: October 2004, recovered 0.5' x 0.5' granite stone up 1'. 25, 30, 31 & 36 is chiseled in top of granite stone. Set magnet on southeast side of stone, made new bearing trees and set reference monuments as shown in plan below.

(c)(d)(e) PLAN VIEW OF CORNER WITH TIES TO AT LEAST 4 WITNESS MONUMENTS. IF IN DISAGREEMENT WITH PREVIOUSLY ESTABLISHED CORNER, SHOW THE DISTANCE BETWEEN THE TWO CORNERS AND ALSO INDICATE THE TIES TO THE DISPUTED CORNER.

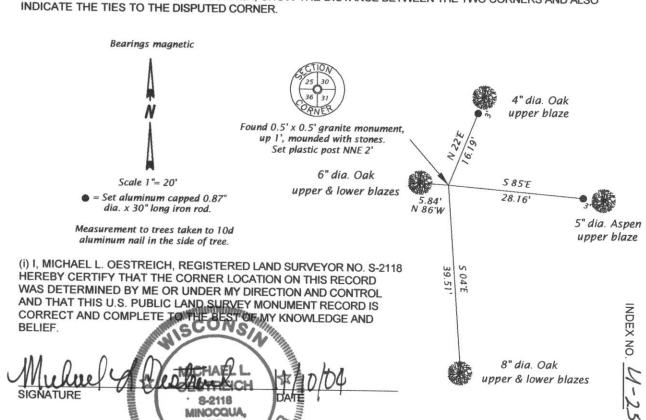

AND THE PROPERTY OF THE PARTY O