


U.S. PUBLIC LAND SURVEY MONUMENT RECORD

NOTE: THIS FORM IS INTENDED AND DESIGNED TO FULFILL ALL REQUIREMENTS OF WISCONSIN ADMINISTRATIVE CODE CHAPTER A-E 7.08 U.S. PUBLIC LAND SURVEY MONUMENT RECORD (3) (a)(b)(c)(d)(e)(f)(g)(h)(i). AN ADDITIONAL SHEET MAY BE ADDED IF NECESSARY TO CONFIRM WITH SAID REQUIREMENTS.

(a) CORNER LOCATION:

W 1/4 CORNER OF SECTION 25
 TOWNSHIP 33 NORTH
 RANGE 5 EAST
 TOWN OF HARDING
 COUNTY OF LINCOLN

RECEIVED BY LINCOLN COUNTY
 SURVEYOR THIS 14TH DAY
 OF December, 20 04
Tom Dahl
 COUNTY SURVEYOR

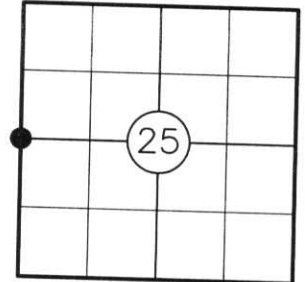

(b) HISTORY OF ORIGINAL CORNER:

ORIGINAL SURVEYOR: JACKSON L. PRENTICE
 DATE OF SURVEY: COMMENCED: NOVEMBER, 1854
 COMPLETED: NOVEMBER, 1854



ORIGINAL BEARING TREES: 12" PINE - S86°W, 18 LKS.
 10" PINE - EAST, 35 LKS
 (NOTE: SPECIES ILLEGIBLE)

(f)(g)(h) DESCRIPTION OF MONUMENT FOUND AT THIS CORNER AND IF IT WAS ACCEPTED STATE ALL EVIDENCE (MATERIAL, TESTIMONIAL, OCCUPATIONAL, PLATS, RECORDS, OTHER MONUMENTS) USED AS A BASIS FOR ESTABLISHING LOCATION. IF REESTABLISHING THROUGH LOST CORNER PROPORTIONATE METHODS, INDICATE ALL MONUMENTS, DISTANCES, AND DIRECTIONS USED TO ESTABLISH. INDICATE TYPE OF MONUMENT AND SIGN POST FOUND OR SET.

1930'S: FRANCIS X. FOX SET STONE MONUMENT AND MOUNDED WITH STONE MIDWAY BETWEEN OPPOSING SECTION CORNERS PER NOTES FILED IN THE LINCOLN COUNTY COURTHOUSE. HE ALSO NOTED AN OLD RAILROAD GRADE NORTH 88' ABOUT 60' WEST OF CUT THROUGH A SMALL HILL.

2004: FOUND AND ACCEPTED 6" X 6" GRANITE STONE MONUMENT IN PLACE 1' ABOVE GROUND AND LEANING OVER IN A MOUND OF STONE. NO BT'S FOUND. OLD RAILROAD GRADE NORTH 88'. PLUMBED STONE MONUMENT, ESTABLISHED TWO BEARING TREES AND SET 2 LINCOLN COUNTY ALUMINUM CAPPED REBAR REFERENCE MONUMENTS AS SHOWN BELOW. SET CARSONITE POST 1' NORTH OF MONUMENT.


(c)(d)(e) PLAN VIEW OF CORNER WITH TIES TO AT LEAST FOUR WITNESSES. IF IN DISAGREEMENT WITH PREVIOUSLY ESTABLISHED CORNER, SHOW THE DISTANCES BETWEEN THE TWO CORNERS AND ALSO INDICATE THE TIE TO THE DISPUTED CORNER.

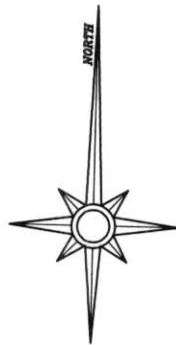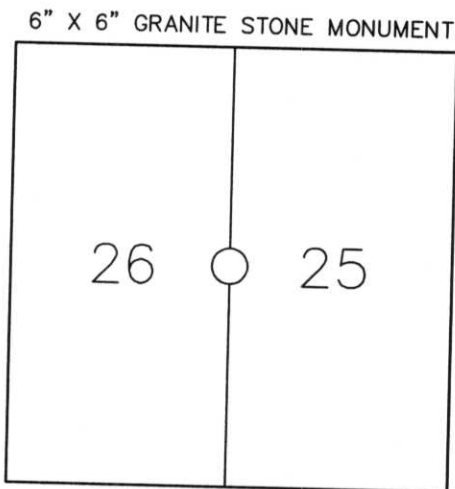

NOT TO SCALE

LEGEND

⊕ SET 7/8" X 30" ALUMINUM CAPPED REBAR

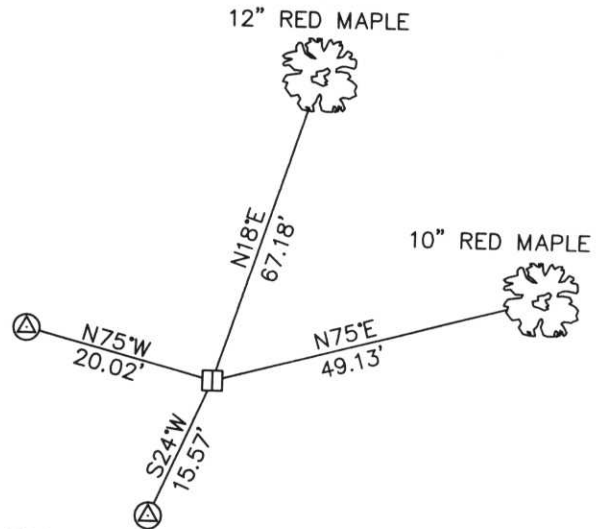


NOTE:
 1) ALL DISTANCES TO BT'S ARE MEASURED TO NAIL ON SIDE OF TREE

I STEPHEN J. FAVORITE, REGISTERED LAND SURVEYOR NO. 1616, HEREBY CERTIFY THAT THE CORNER LOCATION ON THIS RECORD WAS REFERENCED BY ME OR UNDER MY DIRECTION AND CONTROL AND THAT THIS U.S. PUBLIC LAND SURVEY MONUMENT RECORD IS COMPLETE TO THE BEST OF MY KNOWLEDGE AND BELIEF.

Stephen J. Favorite
 SIGNATURE

12-10-04
 DATE

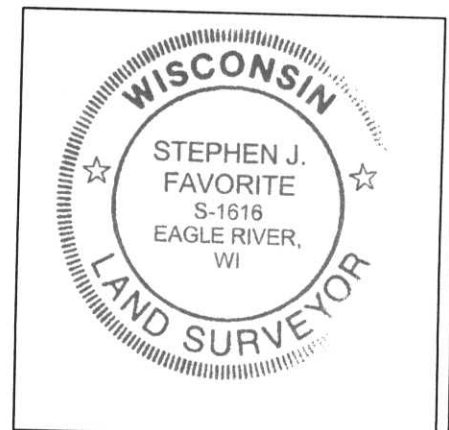

INDEX NO. 5-21