
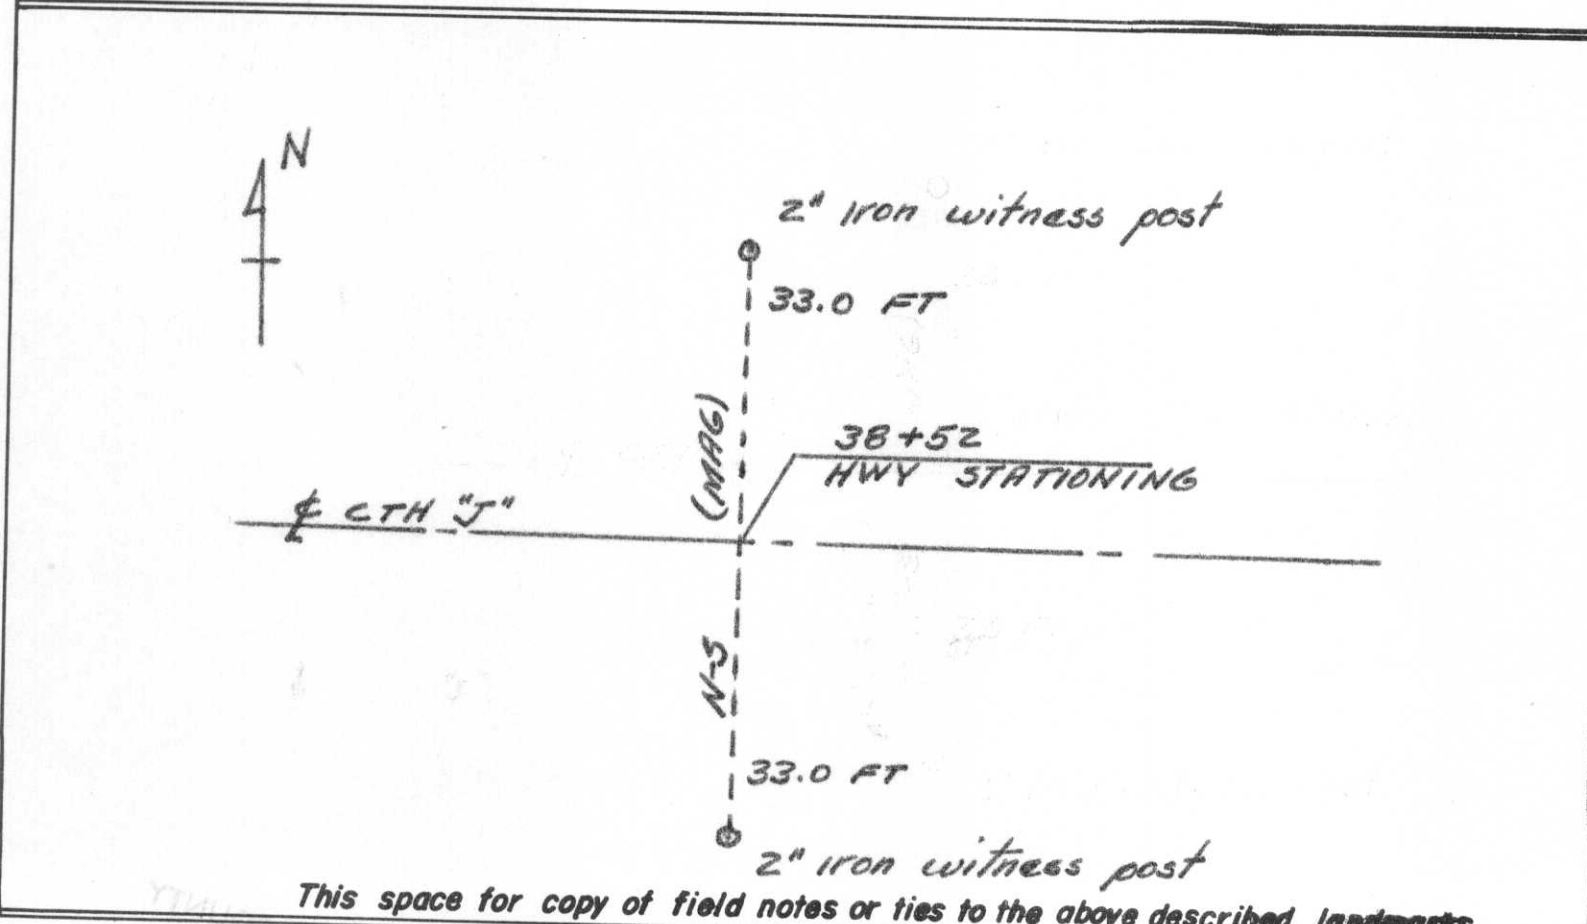


PRESERVATION OF LANDMARKS

SECTION 59,635(7) WISCONSIN STATUTES
 COUNTY LINCOLN
 TOWN ROCK FALLS
 HIGHWAY C.T.H. "J"
 SECTION NOS. 10-11 & 15-14
 T. 33 N., R. 6 E.
 TYPE OF LANDMARK SEC. CORNER
 LOCATION INDICATED ON SKETCH X

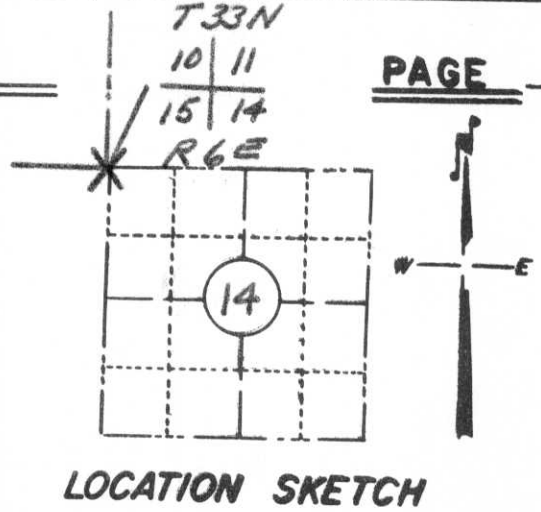

This space for copy of field notes or ties to the above described landmarks

Field notes or records filed in book no. Form 710 on file
 at the WHC, Dist No 7
 City of Rhinelander Oneida office.
 Located or established by PM Johnson County,
 Title Engineer II, 1961

County Clerk's Office _____ County, Wis. } ss
 Received for record _____, 19____



Copy sent to County Surveyor _____, 19____

County Clerk

Index No. I-17

PRESERVATION OF LANDMARKS

SECTION 59,635(7) WISCONSIN STATUTES
 COUNTY LINCOLN
 TOWN ROCK FALLS
 HIGHWAY C.T.H. "J"
 SECTION NOS 10-11 & 15-14
 T. 33 N., R. 6 E.
 TYPE OF LANDMARK SEC. CORNER
 LOCATION INDICATED ON SKETCH X

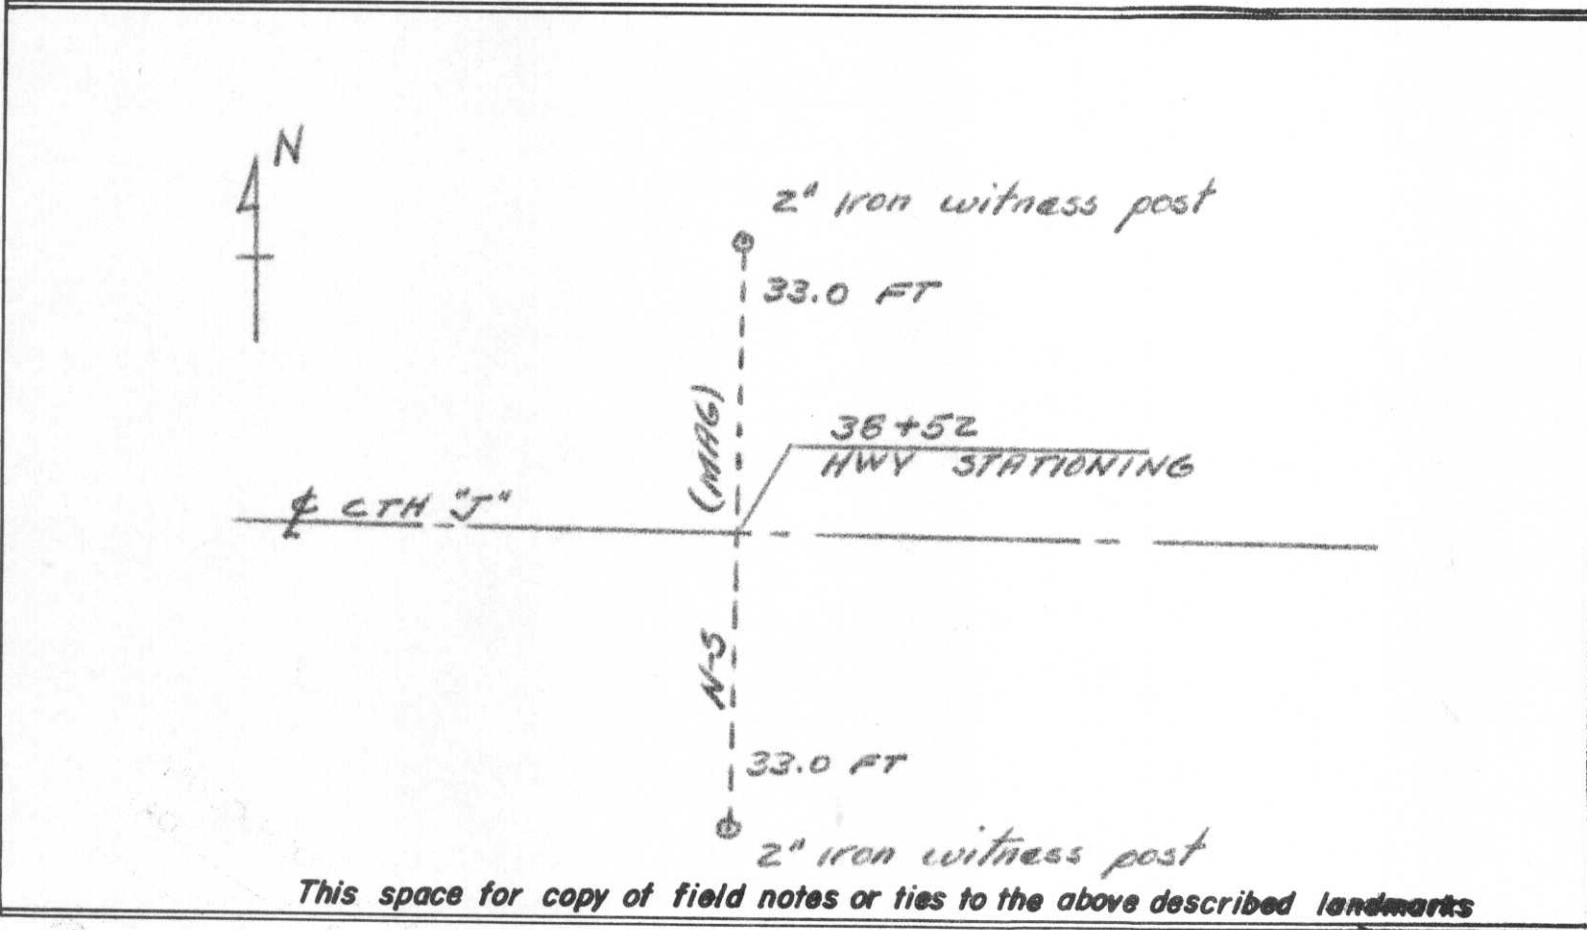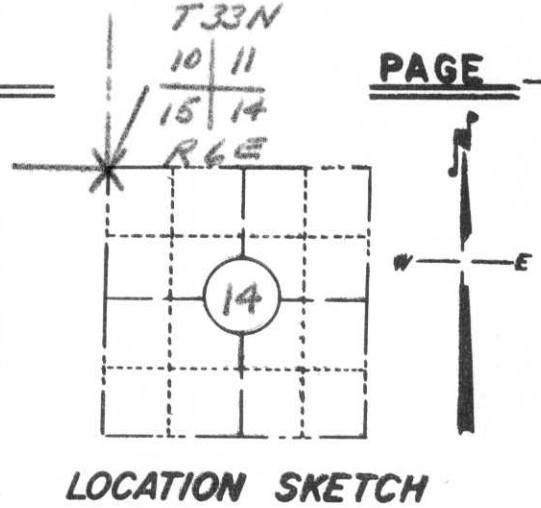

Field notes or records filed in book no. Form 710 on file
 at the WHC, Dist No 7 office.
 City of Rhineland, Oneida County.
 Located or established by PM Johnson, 1961
 Title Engineer II

County Clerk's Office _____ County, Wis. } ss
 Received for record _____, 19____
 Copy sent to County Surveyor _____, 19____


County Clerk

Index No. I-17

LINCOLN COUNTY U.S. PUBLIC LAND SURVEY MONUMENT LOCATION RECORD

CORNER NUMBER 143361
 SECTION 14
 TOWNSHIP 33 NORTH
 RANGE 6 EAST

ROCK FALLS
 CITY, VILLAGE, TOWN

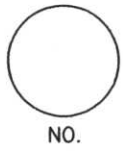

LANDMARK BENCHMARK
 FOUND SET
 RESET
 RE-TIED


CORNER IDENTITY: NORTHWEST CORNER SECTION 14
 LINCOLN COUNTY COORDINATE: N: 185093.02
 E: 385941.69

ELEVATION--(FEET): _____ DATUM: _____

WEATHER: PARTLY CLOUDY

DATE OF SURVEY: 10-28-05 TEMPERATURE: 45 °F

SURVEY PARTY: NATHAN WINCENTSEN, KEITH WALKOWSKI

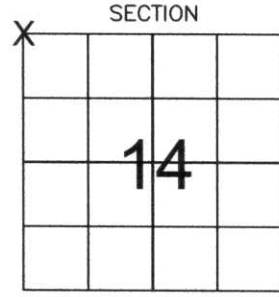

LOCATION (Indicated By X)



BASIS FOR MONUMENT LOCATION:
 (DESCRIBE METHOD OF SURVEY AND CORNER AUTHENTICATION)

DUG FOR NORTHWEST CORNER BY HAND. FOUND SCRIBED GRANITE STONE ±2' BELOW ROAD GRADE. ACCEPTED STONE AS CORNER AND PERPETUATED CORNER LOCATION AS SHOWN BELOW.



CERTIFIED CORRECT:
Keith J. Walkowski

Registered Land Surveyor
 DATE: Nov. 27th, 2005

FIELD BOOK NO. 6 PAGE NO. 12


COMPANY RIVERSIDE LAND SURVEYING LLC

TIE SKETCH: SHOW MINIMUM OF FOUR (4) HORIZONTAL TIE DISTANCES TO FIXED WITNESS MONUMENTS. DESCRIBE ALL MONUMENTS FOUND OR SET. CORRECT ALL DISTANCES SHOWN TO STANDARD TEMPERATURE OF 68° F.

- FOUND GRANITE STONE
- FOUND 3/4" REBAR WITH ALUMINUM CAPS
- VINYL SURVEY MARKER POST

NOTE

- ALL BEARINGS ARE FROM A HAND HELD MAGNETIC COMPASS
- THIS DRAWING IS NOT TO SCALE


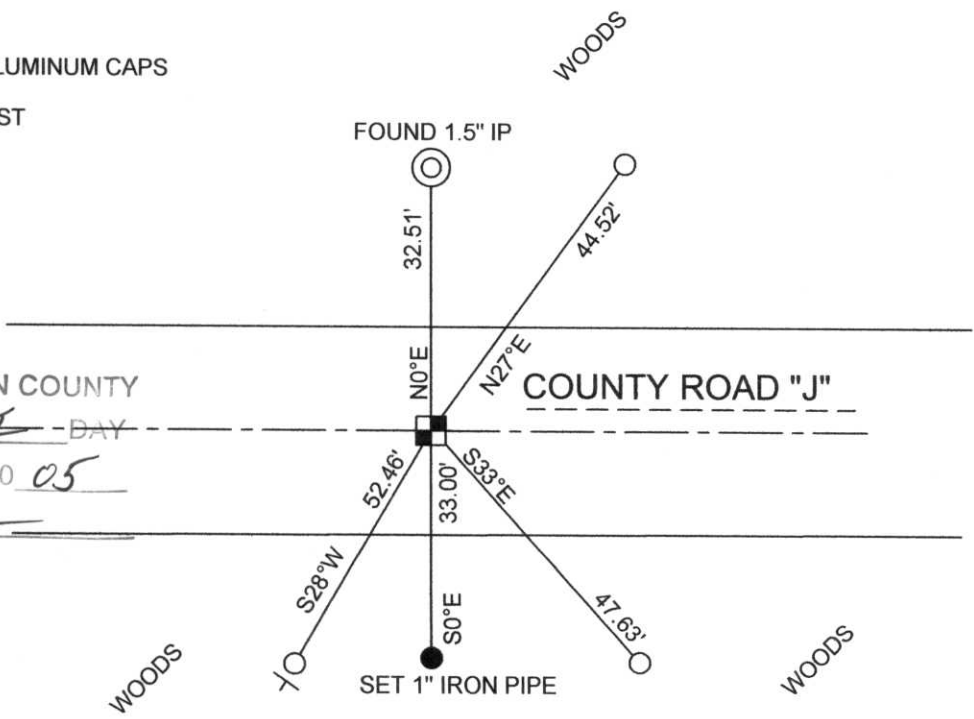


RECEIVED BY LINCOLN COUNTY SURVEYOR THIS 13th DAY OF December 20 05
Tony Dull
 COUNTY SURVEYOR

I-17

PRESERVATION OF LANDMARKS

SECTION 59,635(7) WISCONSIN STATUTES
 COUNTY LINCOLN
 TOWN ROCK FALLS
 HIGHWAY C.T.H. "J"
 SECTION NO. 5 10-11 & 15-14
 T. 33 N., R. 6 E.
 TYPE OF LANDMARK SEC. CORNER
 LOCATION INDICATED ON SKETCH X

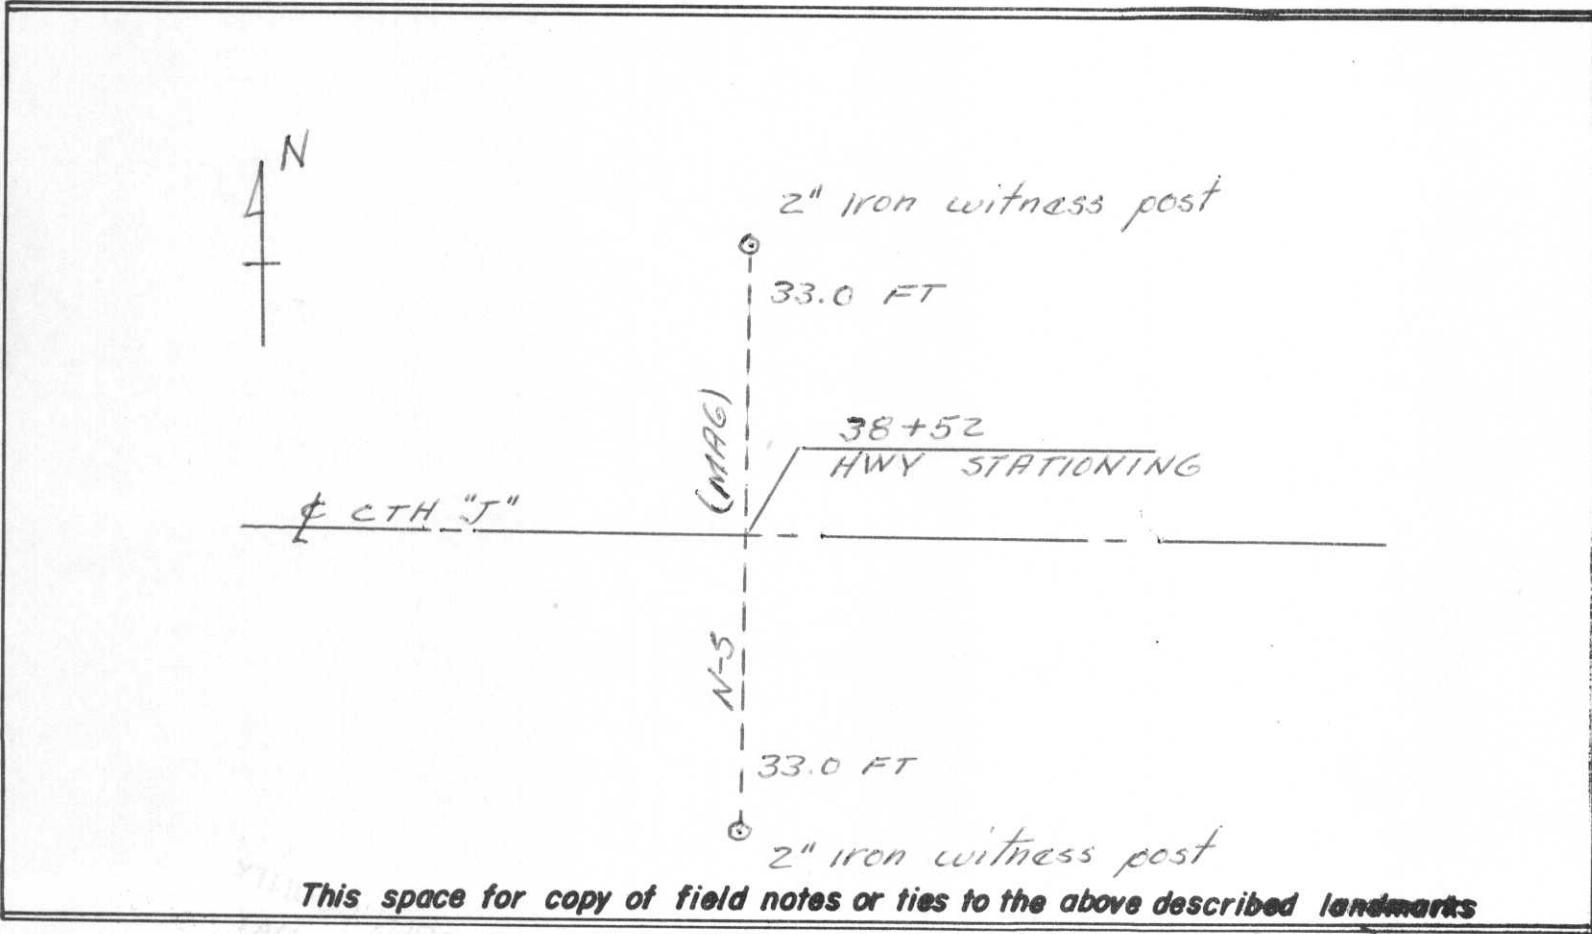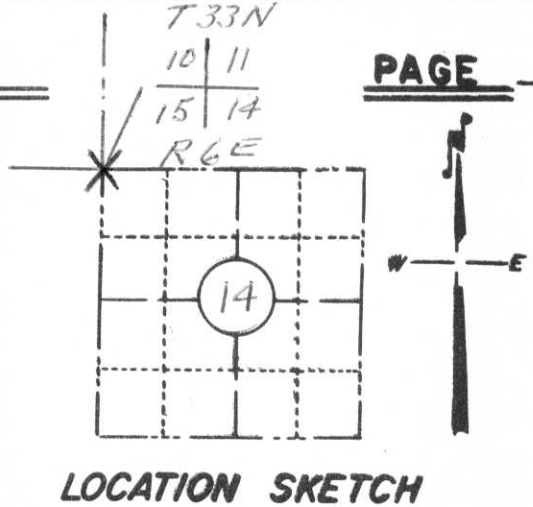

This space for copy of field notes or ties to the above described landmarks

Field notes or records filed in book no. Form 710 on file
 at the W.H.C., Dist No 7 office.
 City of Rhinelander, Oneida County.
 Located or established by P.M. Johnson, 19 61
 Title Engineer II

County Clerk's Office _____ County, Wis. } ss
 Received for record _____, 19 _____

Copy sent to County Surveyor _____, 19 _____

County Clerk

Index No.

I-17

