

PRESERVATION OF LANDMARKS

SECTION 59,635(7) WISCONSIN STATUTES
COUNTY LINCOLN

TOWN ROCK FALLS


HIGHWAY CTH "J"

SECTION NO.S 12 & 13

T. 33 N., R. 6 E.

TYPE OF LANDMARK 1/16 CORNER


LOCATION INDICATED ON SKETCH X

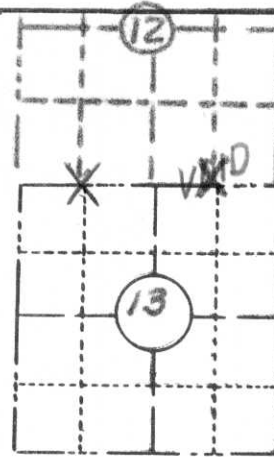

PAGE



LOCATION SKETCH

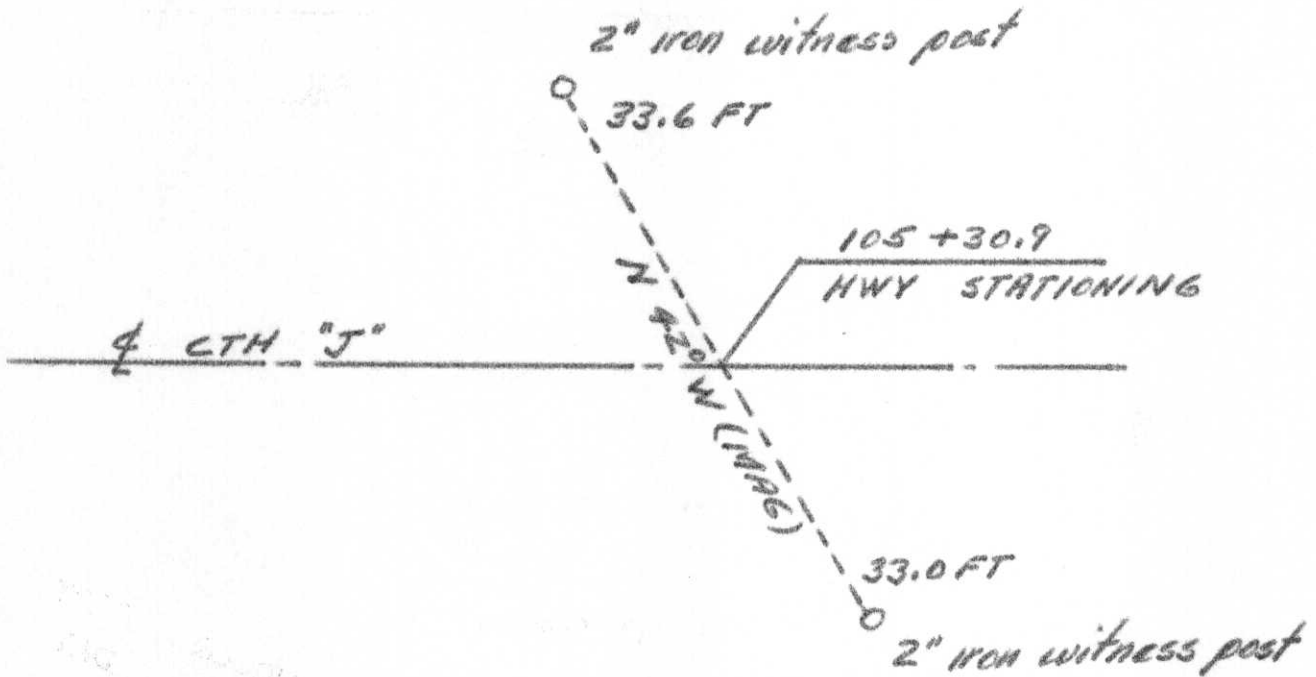

This space for copy of field notes or ties to the above described landmarks

Field notes or records filed in book no. Form 710 on file

at the W.H.C., Dist. No. 7 office.

City of Rhinelander Oneida County.

Located or established by PM Johnson, 19 61

Title Engineer II

County Clerk's Office _____ County, Wis. } ss

Received for record _____, 19 _____

Copy sent to County Surveyor _____, 19 _____

County Clerk

Index No. I-22

PRESERVATION OF LANDMARKS

SECTION 59,635(7) WISCONSIN STATUTES
COUNTY LINCOLN

TOWN ROCK FALLS


HIGHWAY CTH "J"

SECTION NO. 12 & 13

T. 33 N., R. 6 E.

TYPE OF LANDMARK 1/16 CORNER


LOCATION INDICATED ON SKETCH X

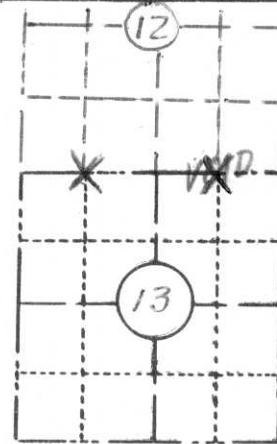

PAGE



LOCATION SKETCH

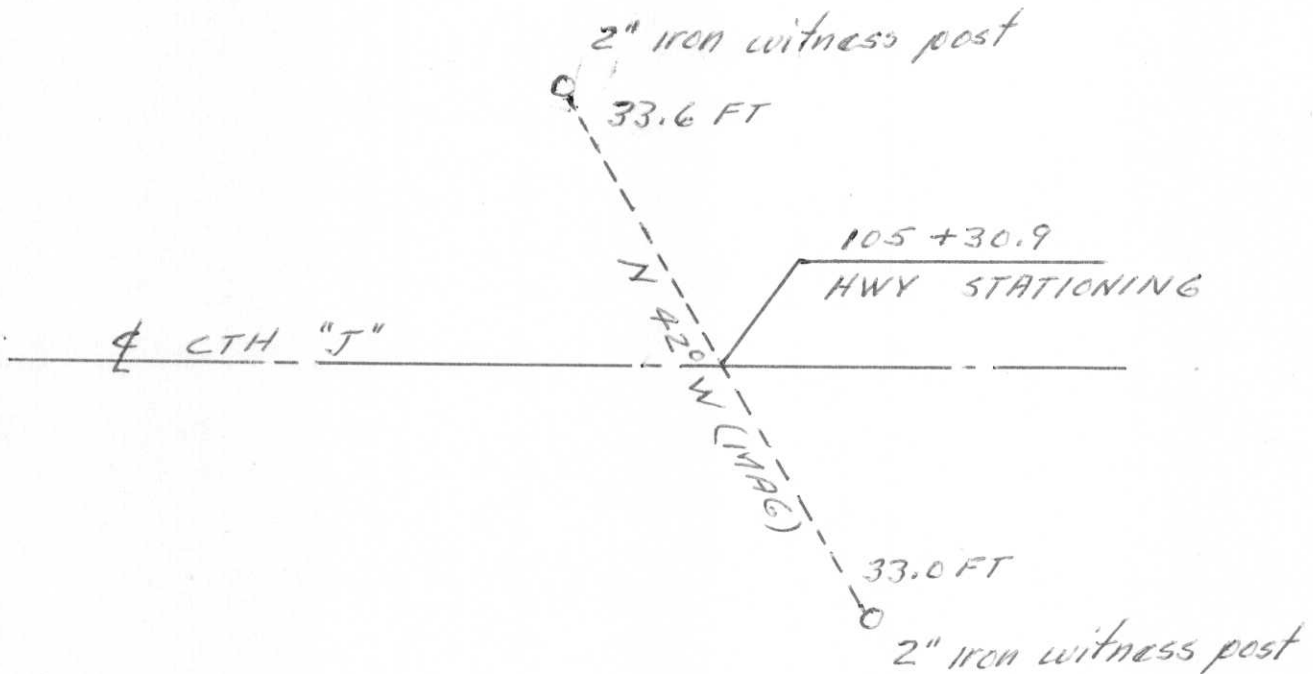

This space for copy of field notes or ties to the above described landmarks

Field notes or records filed in book no. Form 710 on file

at the W.H.C., Dist. No. 7 office.

City of Rhina Lander, Onaida County.

Located or established by PM Johnson, 19 61

Title Engineer II

County Clerk's Office _____ County, Wis. } ss

Received for record _____, 19 _____

Copy sent to County Surveyor _____, 19 _____


County Clerk

Index No. I-22


PRESERVATION OF LANDMARKS

PAGE

SECTION 59,635(7) WISCONSIN STATUTES
 COUNTY LINCOLN
 TOWN ROCK FALLS
 HIGHWAY CTH "J"
 SECTION NO.S 12 & 13
 T. 33 N., R. 6 E.
 TYPE OF LANDMARK 1/16 CORNER
 LOCATION INDICATED ON SKETCH X

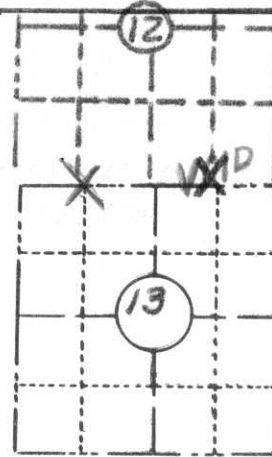

LOCATION SKETCH

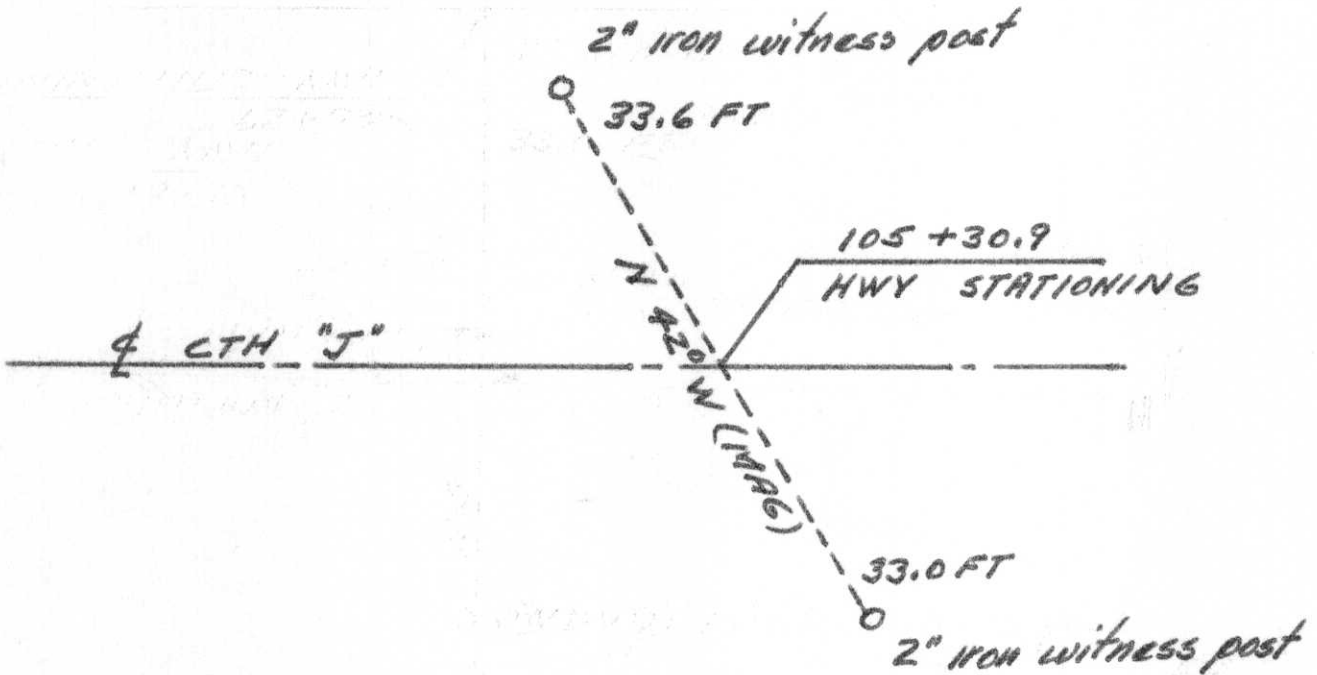

This space for copy of field notes or ties to the above described landmarks

Field notes or records filed in book no. Form 710 on file
 at the W.H.C., Dist. No. 7
 City of Rhina Lander Oneida office.
 Located or established by PM Johnson County.
 Title Engineer II, 19 61

County Clerk's Office _____ County, Wis. } ss
 Received for record _____, 19 _____

Copy sent to County Surveyor _____, 19 _____

County Clerk

Index No. I-22