U.S. PUBLIC LAND SURVEY MONUMENT RECORD

	TI ILLOUID
Note: This form is intended and designed to fulfill all requirements of Wisconsin Administration Public Land Survey Monument Record (3) (a) (b) (c) (d) (e) (f) (g) (h) (i). An additional conform with said requirements.	rative Code, Chapter A-E 5.02, U.S I sheet may be added if necessary t
(a) Corner location: Township 33 North	
Range 6 East	M.C.

ROCK FALLS Town/City/Village LINCOLN County _

16 Section

(b) (f) (g) (h) Description of monument found at this corner and if it was accepted, state all evidence (material, testimonial, occupational, plats, records, other monuments) used as a basis for accepting. If not accepted or if nothing was found, state evidence used as basis for establishing location. If reestablished through lost corner proportionate methods, indicate all monuments, distances and directions used to establish.


Recovered intact a 2" o.d. Iron Pipe at this corner. Pipe found was shown on 1975? survey filed at Lincoln County Tax Description (County Surveyor) by Genisot and was accepted by Sheridan Schwark R.L.S. S-1205 for survey conducted in 1976. (CSM #132, Volume 1 of CSM's, Page 147). Monument found was in harmony with other lot corner iron stakes recovered in area, hence accepted as correct based on these factors. Pipe was not replaced per instructions of County Surveyor as setting new monument could cause bank erosion leading to eventual loss of new monument.

RECEIVED AT LINCOLN COUNTY COURTHOUSE THIS . mo DESCRIPTION **OFFICE** TAX

WI

SURV Mannan Mannan Mannan

(c) (d) (e) Plan view of corner with ties to at least 4 witness monuments. If in disagreement with previously established corner, show the distances between the two corners and also indicate the ties to the disputed corner.

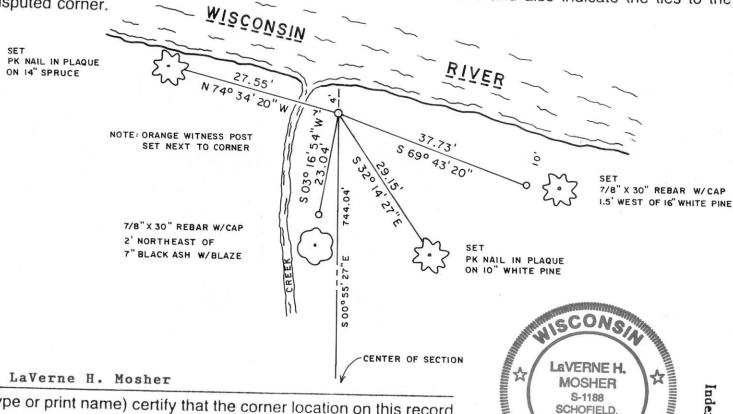

(i) 1.

(type or print name) certify that the corner location on this record was determined by me or under my direction and control and that this U.S. Public Land Survey Monument Record is correct and complete to the best of my knowledge and belief.

Mosher

May 15, 1996

Signature

Date