U.S. PUBLIC LAND SURVEY MONUMENT RECORD


NOTE: This form is intended and designed to fulfill all requirements of Wisconsin Administrative Code, Chapter A-E 7.08 U.S. Public Land Survey Monument Record (3)(a)(b)(c)(d)(e)(f)(g)(h)(i). An additional sheet may be added if necessary to conform with said requirements.

(a) Corner location: Township 33 North

Range 06 East

Town of ROCK FALLS

LINCOLN County, Wisconsin

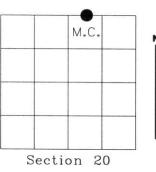

(b)(f)(g)(h) Description of monument found at this corner and if it was accepted, state all evidence (material, testimonial, occupational, plats, records, other monuments) used as a basis for accepting. If not accepted or if nothing was found, state evidence used as basis for establishing location. If reestablished through lost corner proportionate methods, indicate all monuments, distances and directions used to establish. Indicate type of monument found or set and sign post.

- 1865 JAMES L. NOWLIN, SET MEANDER POST AT 28.50 HEMLOCK 12, N 26° E 141ks. HEMLOCK 26, S 1° W 211ks.
- FRANCIS X. FOX, RAN SECTION LINE, DID NOT SET MEANDER 1943 -CORNER
- 2000 ISET MEANDER CORNER BETWEEN NORTH 4CORNER AND NORTHEAST CORNER OF SECTION 20

RECEIVED AT LINCOLN COUNTY COURTHOUSE THIS 10 TH DAY LAND INFORMATION OFFICE

(c)(d)(e) Plan view of corner with ties to at least 4 witness monuments. If in disagreement with previously established corner, show the distances between the two corners and also indicate the ties to the disputed corner. NAIL IN THE SIDE OF 4" ELM TREE

4"DIAMETER BERNTSEN MONUMENT SET


WITNESS MONUMENT %" IRON ROD WITH ALUMINUM TABLET, SET

PLASTIC SIGNPOST 2' WEST

17

S 1863

MC

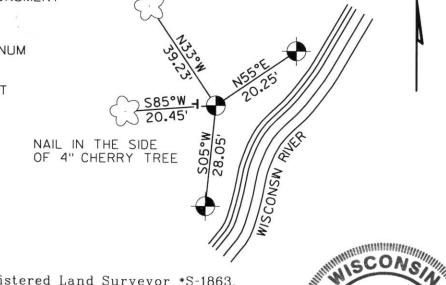

(i) I, Dennis B. Roberts, Registered Land Surveyor *S-1863, hereby certify that the corner location on this record was RHINL WI 540.
WI 540.
SURVE determined by me or under my direction and control and that this U.S. Public Land Survey Monument Record is correct and complete to the best of my knowledge and belief.

Signature

Date

Index No. $\mathcal{M} - 7$: