
| U.S. PUBLIC LAND SURVEY MONUMEN | NT RECORD |
|--|--|
| Note: This form is intended and designed to fulfill all requirements of Wisconsin Administ Public Land Survey Monument Record (3) (a) (b) (c) (d) (e) (f) (g) (h) (i). An additional conform with said requirements. | |
| (a) Corner location: Township 33 North | |
| Range 6 East | M.C. X |
| Town/City/Village ROCK FALLS | |
| CountyLINCOLN | 1 1 |
| | Section 16 |
| (b) (f) (g) (h) Description of monument found at this corner and if it was (material, testimonial, occupational, plats, records, other monuments) us not accepted or if nothing was found, state evidence used as basis reestablished through lost corner proportionate methods, indicate all directions used to establish. | ed as a basis for accepting. If |
| No mention of meander corner in notes of Francis X. Fox Falls Township in 1941. A survey by Genisot from 1975? f County Tax Description Department (County Surveyor) indi was in place at that time. Area where m.c. was recovered rock rip-rap placed along shoreline. No monument found d May 14-15, 1996. West line of section was established frigmediate. | iled with the Lincoln cates a Meander corner has been graded and uring our survey on |
| immediate area. Set a 7/8" x 30" rebar topped with 2" di | sk at corner such that |

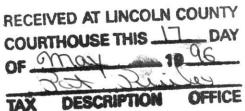

LaVERNE H

(c) (d) (e) Plan view of corner with ties to at least 4 witness monuments. If in disagreement with previously established corner, show the distances between the two corners and also indicate the ties to the FOUND I-1/4" RON PIPE 75.50 FOUND I-I/4" IRON PIPE ON FOUND I-1/4" IRON PIPE NORTH R/W S.T.H. "107" NORTH FOUND
I"IRON PIPE ON
NORTH R/W S.T.H."107" annumum minumum mana 1/4 CORNER (i) | LaVerne H. Mosher SCH WI

(type or print name) certify that the corner location on this record was determined by me or under my direction and control and that this U.S. Public Land Survey Monument Record is correct and complete to the best of my knowledge and belief.

monument is flush with lawn surface.

Signature

May 15, 1996

Date