U.S. PUBLIC LAND SURVEY MONUMENT RECORD


Note: This form is intended and designed to fulfill all requirements of Wisconsin Administrative Code, Chapter A-E 5.02, U.S Public Land Survey Monument Record (3) (a) (b) (c) (d) (e) (f) (g) (h) (i). An additional sheet may be added if necessary to conform with said requirements.

(a) Corner location: Township 33 North

Range 6 East


Town/City/Village ____Rock Falls

County ___Lincoln

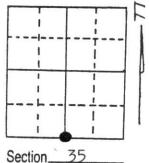

(b) (f) (g) (h) Description of monument found at this corner and if it was accepted, state all evidence (material, testimonial, occupational, plats, records, other monuments) used as a basis for accepting. If not accepted or if nothing was found, state evidence used as basis for establishing location. If reestablished through lost corner proportionate methods, indicate all monuments, distances and directions used to establish. Original Gov't. Survey: August 1851 by James M. Marsh, set wood post for corner with bearings, hemlock 8 5 56° E 25 links, hemlock 8 5 32° W 34 links, hemlock 10 N 37 W 30 links & hemlock 9 N 68° E 18 links. During a survey of the Town of Rock Falls in the 1930's by Francis Fox, he set a gray granite stone 4' south of the centerline of road 12" below the top of the road for the corner & offset an iron pipe north 24.75' for a witness to the corner. After Mr. Fox's survey, the roadway was extensively cut and apparently the granite & iron pipe witness were removed. In 1968, James G. Griffin reestablished the corner location and set a 2" iron pipe for the corner during the platting of Wilderness Shores Subdivision & witnessed the corner with a 10" oak S 10° E 56.7'. In 1971, John H. Fisher during the platting of Wilderness Acres Subdivision established witnesses to the corner of a 6" maple N 61° E 74.6' and a 2" iron pipe N 1°08" W 33.01', which is the Southeast corner of Lot 6, Wilderness Acres Subdivision. I have replaces the 2" iron pipe with a Berntsen monument for the corner location. The 3 witnesses last mentioned above are in good shape & I set a fouth as shown below.

(c) (d) (e) Plan view of corner with ties to at least 4 witness monuments. If in disagreement with previously established corner, show the distances between the two corners and also indicate the ties to the disputed corner.

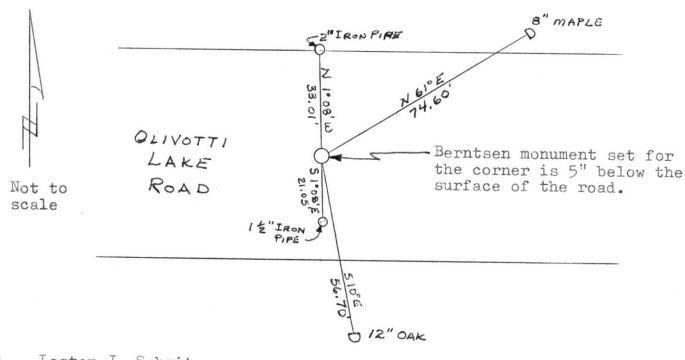

(i) I, Lester J. Schmit

(type or print name) certify that the corner location on this record was determined by me or under my direction and control and that this U.S. Public Land Survey Monument Record is correct and complete to the best of my knowledge and belief.

Lester J. & Chmild Signature 57700 92 Date



Index No.