



78.

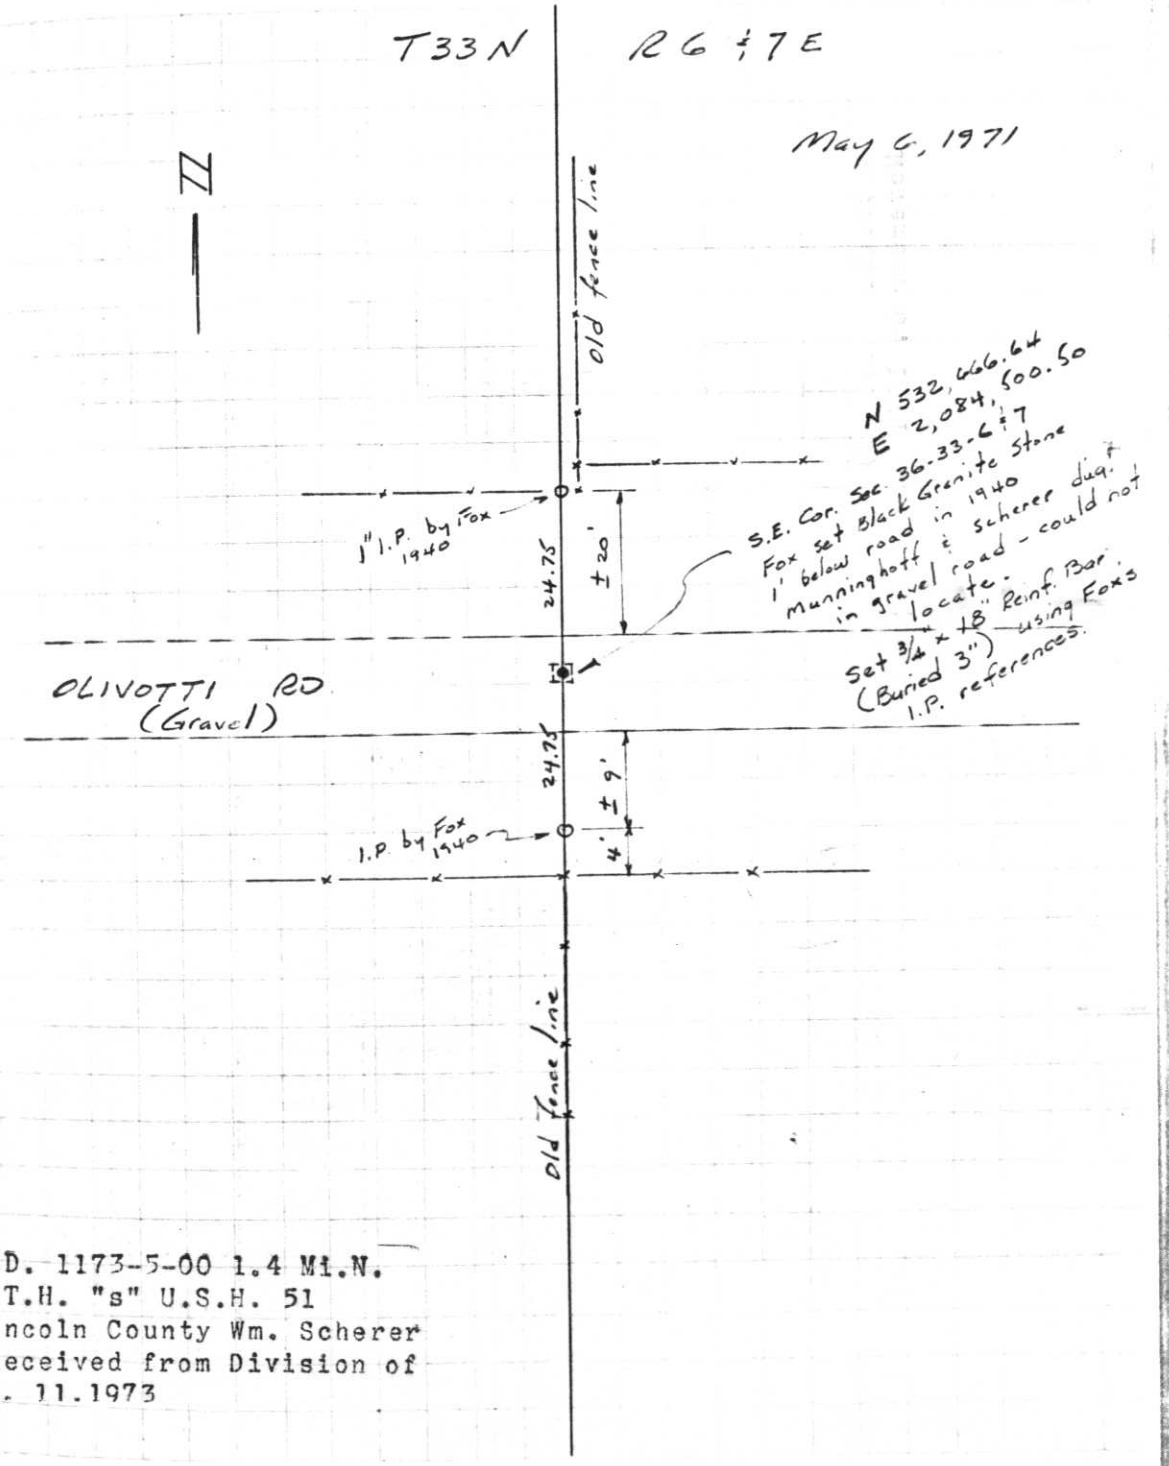

Project I.D. 1173-5-00 1.4 Mi.N.
Merrill-C.T.H. "s" U.S.H. 51
Freeway Lincoln County Wm. Scherer
Surveyor Received from Division of
Hwy's. Jan. 11.1973

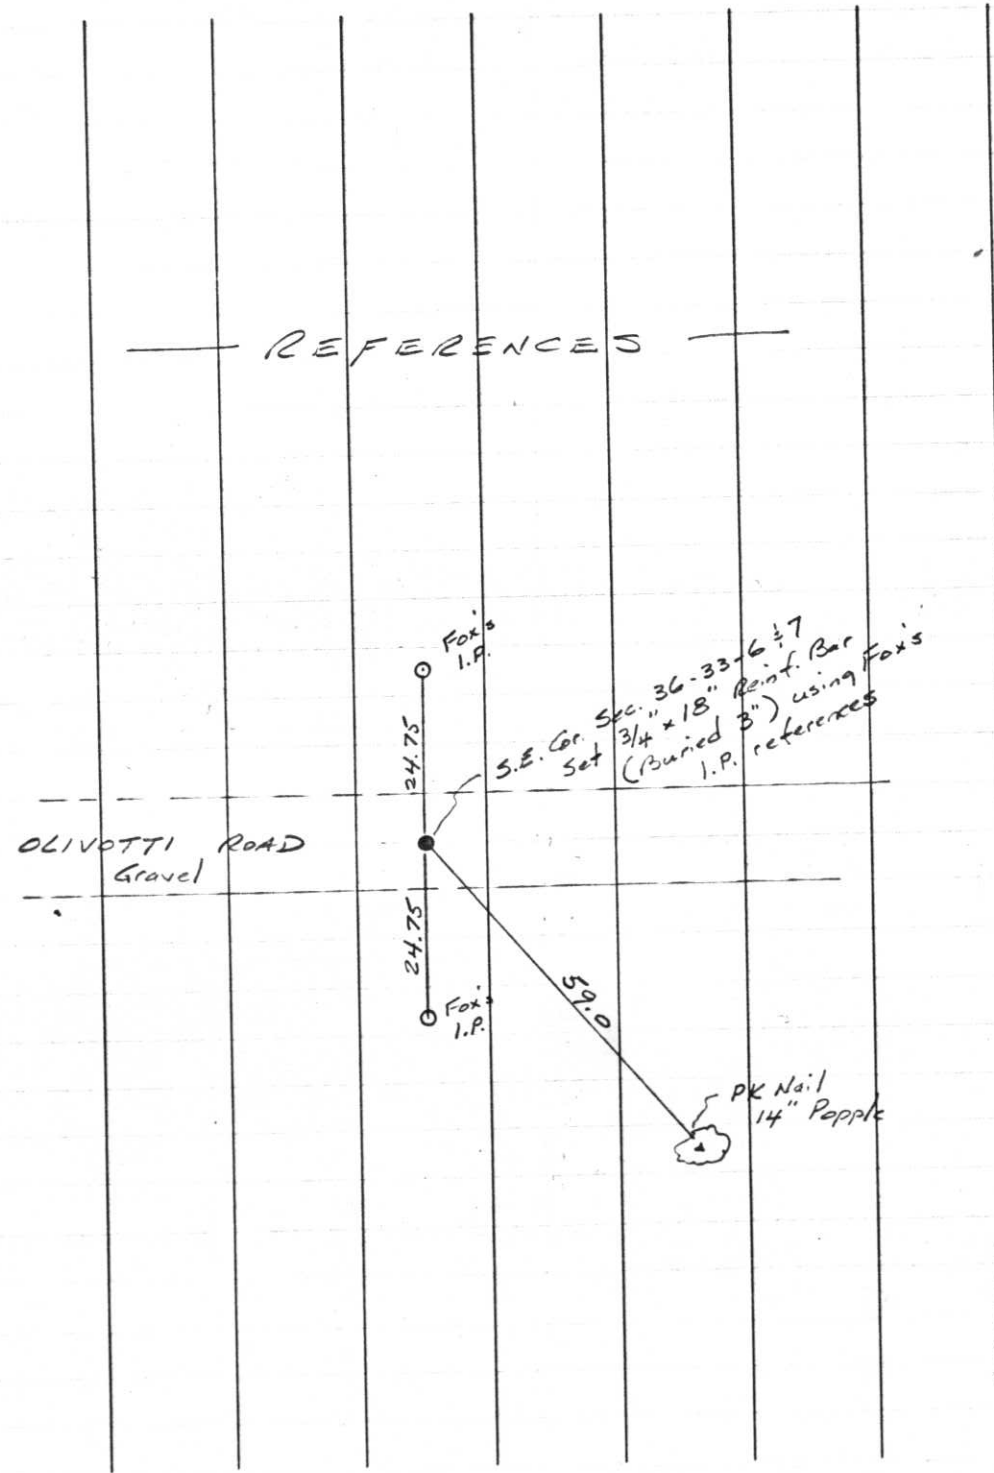

12 3:41 PM



12 3:41 PM



12 3:41 PM