

# Attachment to Tie Sheet Q-15, T33N, R7E

## 43307220020

I visited the corner on 10/16/2018 to verify the corner and reference tie monumentation. I found the Granite monument, up 1", and all 4 ties from William Nutter's tie sheet (08/18/1998). The established Coordinates and 3 of the 4 ties agree with existing monument.

Northerly witness measures 22.48', shown as 27.48 on Tie Sheet, and has the Carsonite Post.

Easterly witness measures 11.33', shown as 11.27 on Tie Sheet, 8" Balsam is dead.

Southeasterly witness measurement checked, 6" Balsam is dead.

Southerly witness measurement checked.

 4/02/19

Anthony R. Dallman, PLS-2405


Lincoln County Surveyor



# U.S. PUBLIC LAND SURVEY MONUMENT RECORD

Note: This form is intended and designed to fulfill all requirements of Wisconsin Administrative Code, Chapter A-E 5.02, U.S. Public Land Survey Monument Record (3) (a) (b) (c) (d) (e) (f) (g) (h) (l). An additional sheet may be added if necessary to conform with said requirements.

(a) Corner location: Township 33 North  
 Range 7 East  
 Town/City/Village BIRCH  
 County Lincoln

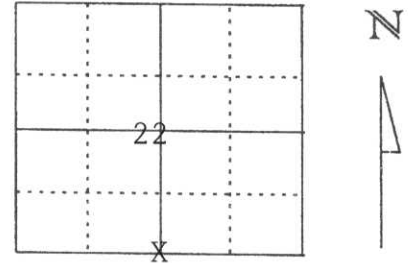


Section 22

(b) (f) (g) (h) Description of monument found at this corner and if it was accepted, state all evidence (material, testimonial, occupational, plats, records, other monuments) used as a basis for accepting. If not accepted or if nothing was found, state evidence used as basis for establishing location. If reestablished through lost corner proportionate methods, indicate all monuments, distances and directions used to establish.

Found a 7"x7" red granite stone with a green post along side. Stone was marked on top "1/4 S". Accepted this as the corner. Tied out to 7/8" rebar witness monuments with Lincoln County Caps.

(c) (d) (e) Plan view of corner with ties to at least 4 witness monuments. If in disagreement with previously established corner, show the distances between the two corners and also indicate the ties to the disputed corner.

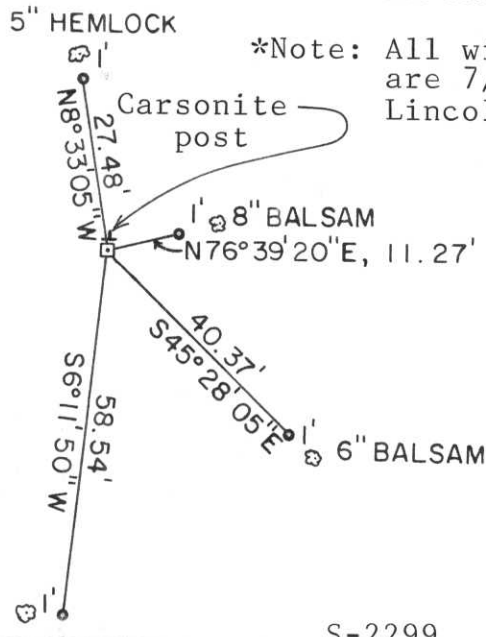

RECEIVED AT LINCOLN COUNTY  
 COURTHOUSE THIS 15 DAY  
 OF Sept. 19 98  
 Tax Description Office

(l) I, William W. Nutter 12" MAPLE S-2299  
 (type or print name) certify that the corner location on this record was determined by me or under my direction and control and that this U.S. Public Land Survey Monument Record is correct and complete to the best of my knowledge and belief.  
William W. Nutter 8-18-98  
 Signature Date

Index No. Q-15









