
	This form is intended and designed to fulfill all requirements of Wisconsin Add Public Land Survey Monument Record (3) (a) (b) (c) (d) (e) (f) (g) (h) (i). An add conform with said requirements.	ministrative Code, Chapter A-E 5.02, U.S. litional sheet may be added if necessary to
(a) C	forner location: Township 33 North	
	RangeEast	
Town	Birch	
Coun	ntyLincoln	1 1
		Section 32
no	naterial, testimonial, occupational, plats, records, other monument of accepted or if nothing was found, state evidence used as restablished through lost corner proportionate methods, indical	basis for establishing location If
se S	rections used to establish. Original Gov't. Survey: Oct twood post for corner with bearings, tamarac 8 N 42° E 69 links. Found a 6" x 6" granite monument truce & tamarack swamp.	t. 1854 by Jackson Prentice 2° E 50 links & tamarac 8
se S	t wood post for corner with bearings, tamarac 8 N	t. 1854 by Jackson Prentice 2° E 50 links & tamarac 8
se S	42° E 69 links. Found a 6" x 6" granite monument	t. 1854 by Jackson Prentice 2° E 50 links & tamarac 8
se S	42° E 69 links. Found a 6" x 6" granite monument	t. 1854 by Jackson Prentice 2° E 50 links & tamarac 8

c) (d) (e) Plan view of corner with ties to at least 4 witness monuments. If In disagreement with previously established corner, show the distances between the two corners and also indicate the ties to the disputed corner.

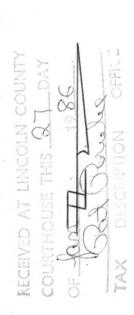

Granite monument is corner.

Lester J. Schmit (type or print name) certify that the corner location on this record was determined by me or under my direction and control and that this U.S. Public Land Survey Monument Record is correct and complete to the best of my knowledge and belief.

Signature

