


# U.S. PUBLIC LAND SURVEY MONUMENT RECORD

Note: This form is intended and designed to fulfill all requirements of Wisconsin Administrative Code, Chapter A-E 5.02, U.S. Public Land Survey Monument Record (3) (a) (b) (c) (d) (e) (f) (g) (h) (i). An additional sheet may be added if necessary to conform with said requirements.

(a) Corner location: Township 33 North  
 Range 8 East/~~West~~  
 Town/City/Village Russell  
 County Lincoln

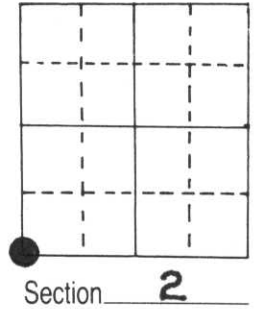

(b) (f) (g) (h) Description of monument found at this corner and if it was accepted, state all evidence (material, testimonial, occupational, plats, records, other monuments) used as a basis for accepting. If not accepted or if nothing was found, state evidence used as basis for establishing location. If reestablished through lost corner proportionate methods, indicate all monuments, distances and directions used to establish.


Original by Jackson L. Prentive, 1854, BTs Heml 12" S55°W 32 lks., BW 11" S70°E 25 lks., Heml 10" N45°W 25 lks., BW 20" N25°E 50 lks.

D.O.T. 1959 Hwy plan shows corner in intersection of Hwy 17 and town road. New 17 is more west now but old road is still there. Adam Miller indicated that the corner had been in the intersection.

In 1988 I dug with a backhoe a large area but found nothing.

Set an aluminum monument flush with road in intersection.

(c) (d) (e) Plan view of corner with ties to at least 4 witness monuments. If in disagreement with previously established corner, show the distances between the two corners and also indicate the ties to the disputed corner.

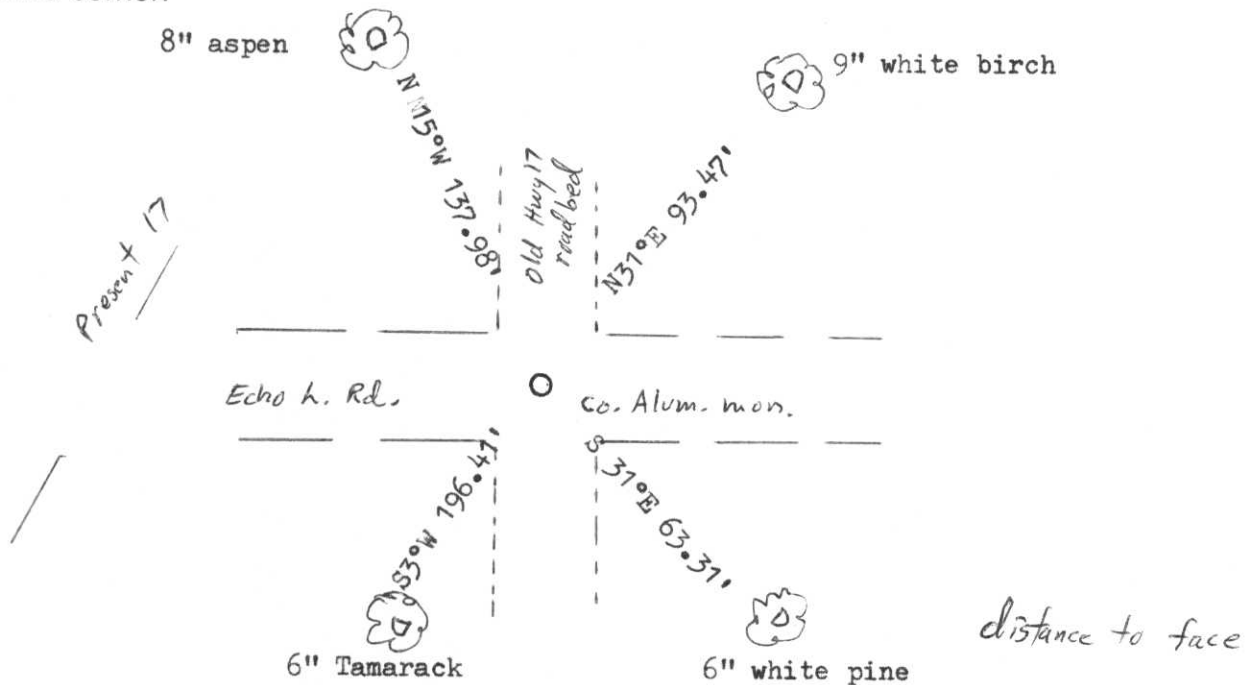

(i) I, Marvin E. Seymour  
 (type or print name) certify that the corner location on this record was determined by me or under my direction and control and that this U.S. Public Land Survey Monument Record is correct and complete to the best of my knowledge and belief.

Marvin E. Seymour Signature      Oct. 7, 1988 Date

