

U.S. PUBLIC LAND SURVEY MONUMENT RECORD


Note: This form is intended and designed to fulfill all requirements of Wisconsin Administrative Code, Chapter A-E 5.02, U.S. Public Land Survey Monument Record (3) (a) (b) (c) (d) (e) (f) (g) (h) (i). An additional sheet may be added if necessary to conform with said requirements.

(a) Corner location: Township 33 North

Range 8 East

Town RUSSELL

County LINCOLN

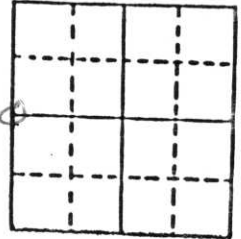

Section 4

b) (f) (g) (h) Description of monument found at this corner and if it was accepted, state all evidence (material, testimonial, occupational, plats, records, other monuments) used as a basis for accepting. If not accepted or if nothing was found, state evidence used as basis for establishing location. If reestablished through lost corner proportionate methods, indicate all monuments, distances and directions used to establish.


CORNER NOT FOUND. CONDUCTED EXTENSIVE SEARCH, SET CORNER BY PROPORTIONATE METHODS, USING ORIGINAL GOV. NOTES. USED THE NW, SE, SW CORNERS OF SECTION 4, TOTAL DISTANCE 5295.209. SOUTH 1/2 MILE DISTANCE 2650.918, NORTH 1/2 MILE 2644.291

CORNER IS A 2" IRON PIPE WITH BRASS CAP

c) (d) (e) Plan view of corner with ties to at least 4 witness monuments. If in disagreement with previously established corner, show the distances between the two corners and also indicate the ties to the disputed corner.

BEARING TREES W/4 CORNER 4-33-8

- ① 3" BLACK SPRUCE S25°E 31.30'
- ② 2" " " N20°E 26.70'
- ③ 8" HARD MAPLE N77°E 64.16'
- ④ 7" " " N61°E 62.20'

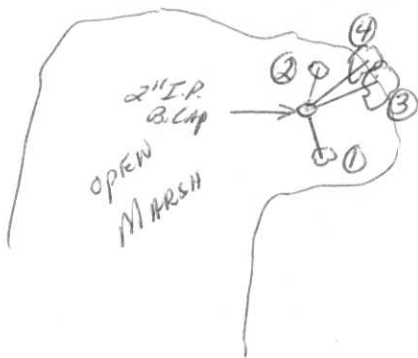

(i) I, WILLIAM E. WENSELER
 (type or print name) certify that the corner location on this record was determined by me or under my direction and control and that this U.S. Public Land Survey Monument Record is correct and complete to the best of my knowledge and belief.

William E. Wenseler 17 Nov 88
 Signature Date

Index No. C-9