

CERTIFIED LAND CORNER RESTORATION


Index No. I-15

State of Wisconsin }  
County of Lincoln } ss.

I Sheridan D. Schwark do hereby certify that on the 20th day of June, 19 78, I found evidence of the North one-quarter corner of Section 15 Township 33, North, Range 8 East, Fourth, Principal Meridian, as described hereon; and that from this evidence I established a new monument and accessories as described hereon to perpetuate the original location of this corner.

Resident witnesses:

.....  
.....  
.....

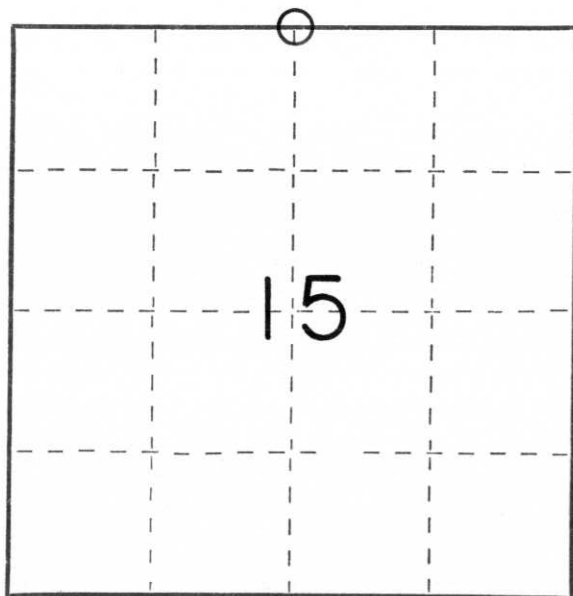

○ = Corner monument restored.

History of original corner establishment:

Date: October, 1854  
Surveyor: Jackson Prentice  
Monument: Wood Post  
Witnesses: 14" Birch, S10°E, 27 links  
10" Hemlock, N58°W, 28 links

Description of corner evidence found:

A 6" x 6" red granite monument was found in place.

Description of monument and accessories I established to perpetuate the original location of this corner.

We set the following witness monuments to the monument described above:  
Aluminum cap in concrete set as bench mark by Dept. of Natural Resources bearing S10°W, 9.03'  
1 1/4" x 30" solid round iron rod set 1' southerly of 12" maple bearing N72°E, 8.78'  
1 1/4" x 30" solid round iron rod set between two 7" poplars bearing N55°E, 36.12'  
1 1/4" x 30" solid round iron rod set 1' southerly of three 4" maples, bearing N14°E, 21.70'

Dated at Merrill, Wis., this 23 rd day of June, 19 78.

Signature Sheridan D. Schwark Title Registered Land Surveyor Registration No. 1205  
(County Surveyor, Registered Land Surveyor, or other duly authorized official)

Office of Register of Deeds, County of \_\_\_\_\_, I hereby certify that the within instrument was filed in this office for record on the \_\_\_\_\_ day of \_\_\_\_\_, 19 \_\_\_\_\_ at \_\_\_\_\_ o'clock \_\_\_\_\_ M.

.....  
(Register of Deeds)

By \_\_\_\_\_ Deputy