

CERTIFIED LAND CORNER RESTORATION

93-9

Index No. ~~H-23~~

State of Wisconsin }
County of Langlade } ss.

History of original corner establishment:

Corner set in the 1930 resurvey.

S 1/16 Sec 12-33-8

I Raymond J. Hallsy, do hereby certify that on the 16 day of November, 1969, I found evidence of the S 1/16 corner of Section 7 Township 33, North, Range 9E, Fourth, Principal Meridian, as described hereon; and that from this evidence I established a new monument and accessories as described hereon to perpetuate the original location of this corner.

Description of corner evidence found:

Found old stake leaning, marked s/16 S 7 Cor 50 LKS W.

Resident witnesses:


.....
.....
.....

Description of monument and accessories I established to perpetuate the original location of this corner.

Set 2" pipe with brass cap, rock mound.
B.T.'s to witness corner.
8" White Spruce N31E 6 Ft. 7 inches.
11" Red Maple S44E 10 Ft. 11 inches.
B.T.'s faced at base of tree and scribed BT.



FORM 985 M. C. MILLER CO., MILWAUKEE

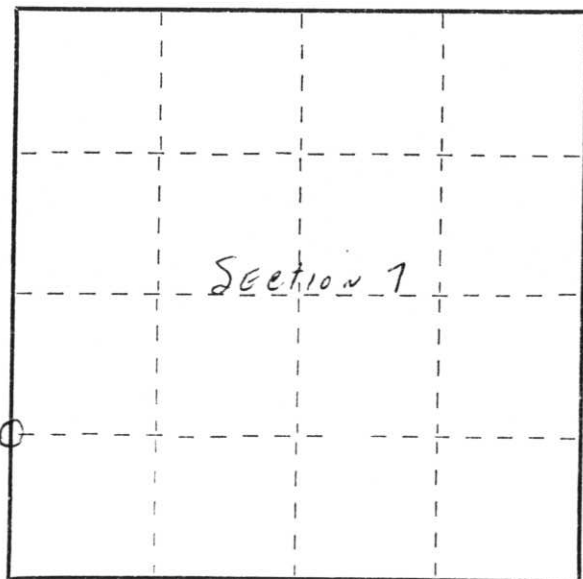

○ = Corner monument restored.

Dated at Antigo, Wis., this 16th day of November, 19 69

Signature Raymond J. Hallsy Title Reg. Land Surveyor Registration No. S-685
(County Surveyor, Registered Land Surveyor, or other duly authorized official)

Office of Register of Deeds, County of _____, I hereby certify that the within instrument was filed in this office for record on the _____ day of _____, 19 _____ at _____ o'clock _____ M.

.....
(Register of Deeds)

By _____ Deputy

LAND INFORMATION OFFICE
COUNTY HOUSE
MILWAUKEE, WISCONSIN

CERTIFIED LAND CORNER RESTORATION

99-9

H-25

Index No. ~~H-1~~

State of Wisconsin }
County of Langlade } ss.

I Raymond J. Hallisy, do hereby certify that on the 16 day of November, 1969, I found evidence of the S 1/16 corner of Section 7 Township 33, North, Range 9E, Fourth, Principal Meridian, as described hereon; and that from this evidence I established a new monument and accessories as described hereon to perpetuate the original location of this corner.

History of original corner establishment:

Corner set in the 1930 resurvey.

Description of corner evidence found:

Found old stake leaning, marked s/16 S 7 Cor 50 LKS W.

Resident witnesses:

.....
.....
.....


Description of monument and accessories I established to perpetuate the original location of this corner.

Set 2" pipe with brass cap, rock mound.
B.T.'s to witness corner.
8" White Spruce N31E 6 Ft. 7 inches.
11" Red Maple S44E 10 Ft. 11 inches.
B.T.'s faced at base of tree and scribed BT.



FORM 985 M. C. MILLER CO., MILWAUKEE

12-33-8

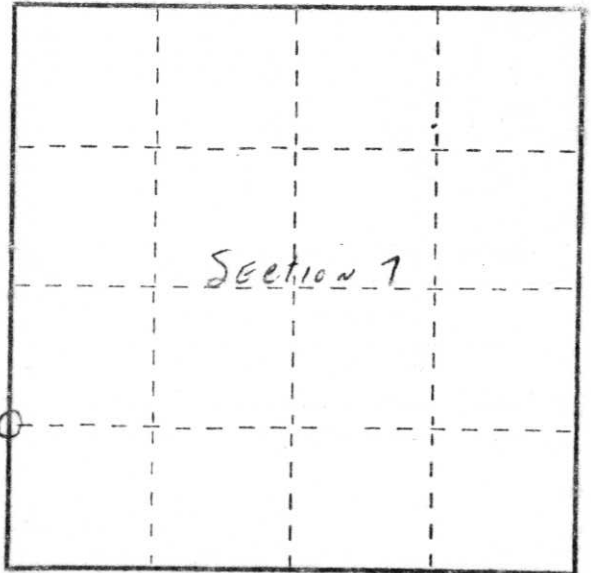

○ = Corner monument restored.

12-33-8
S E 1/8

Dated at Antigo, Wis., this 16th day of November, 1969

Signature: Raymond J. Hallisy Title Reg. Land Surveyor Registration No. S-685
(County Surveyor, Registered Land Surveyor, or other duly authorized official)

Office of Register of Deeds, County of _____, I hereby certify that the within instrument was filed in this office for record on the _____ day of _____, 19____ at _____ o'clock _____ M.

(Register of Deeds)

By _____ Deputy