

CERTIFIED LAND CORNER RESTORATION

334

F-25
F-1

Index No.

State of Wisconsin }
County of Langlade } ss.

I Raymond J. Hallisy do hereby certify that on the 16th day of November, 1969, I found evidence of the N 1/16 corner of Section 7 Township 33, North, Range 9E, Fourth, Principal Meridian, as described hereon; and that from this evidence I established a new monument and accessories as described hereon to perpetuate the original location of this corner.

N 1/16 Sec 12-33-8

History of original corner establishment:

Corner set in the 1930 resurvey.

Description of corner evidence found:


Found old stake standing, marked N 1/8 S7 Cor 50 LKS W.

Resident witnesses:

.....
.....
.....

Description of monument and accessories I established to perpetuate the original location of this corner.

Set 2" pipe with brass cap.
B.T.'s to witness corner.
6" Aspen S44E 17 FT. 10 inches.
5" Elm N25E 13 FT. 6 inches.
B.T.'s faced at base of tree and scribed BT.

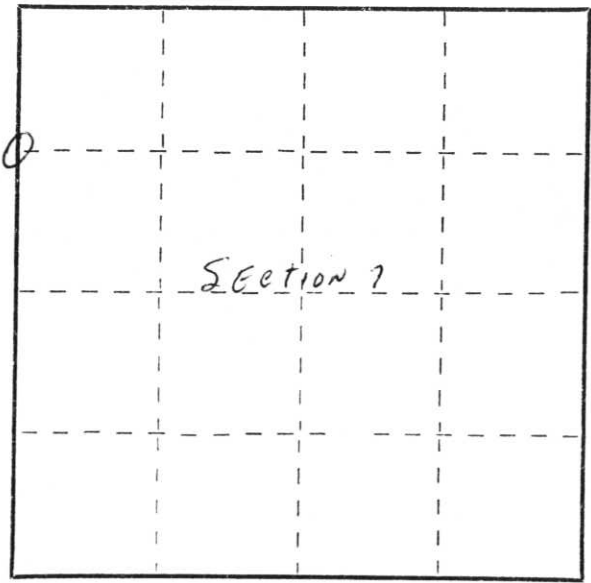

○ = Corner monument restored.

Dated at Antigo, Wis., this 16th day of November, 1969

Signature Raymond J. Hallisy Title Reg. Land Surveyor Registration No. S-685
(County Surveyor, Registered Land Surveyor, or other duly authorized official)

Office of Register of Deeds, County of _____, I hereby certify that the within instrument was filed in this office for record on the _____ day of _____, 19____ at _____ o'clock _____ M.

.....
(Register of Deeds)

By.....Deputy

FORM 885 H. C. MILLER CO., MILWAUKEE

LAND INFORMATION SERVICE
RECEIVED THIS OFFICE
NOV 17 1969
12:17
WE 1 N 1/16
COR 50 LKS W

CERTIFIED LAND CORNER RESTORATION

339 Index No. F-25
~~F-1~~

State of Wisconsin }
County of Lanlade } ss.

History of original corner establishment:

I Raymond J. Hallisy do hereby certify that on the 16th day of November, 1969, I found evidence of the N 1/16 corner of Section 7 Township 33, North, Range 9E, Fourth, Principal Meridian, as described hereon; and that from this evidence I established a new monument and accessories as described hereon to perpetuate the original location of this corner.

Corner set in the 1930 resurvey.

Description of corner evidence found:


Found old stake standing, marked N 1/8 S7 Cor 50 LKS W.

Resident witnesses:

.....
.....
.....

Description of monument and accessories I established to perpetuate the original location of this corner.

Set 2" pipe with brass cap.
B.T.'s to witness corner.
6" Aspen S44E 17 FT. 10 inches.
5" Elm N25E 13 FT. 6 inches.
B.T.'s faced at base of tree and scribed BT.

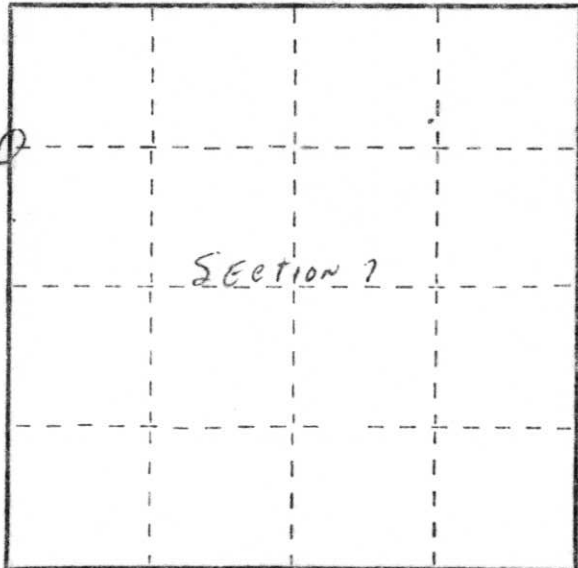

12-33-8

12-33-8
~~12-33-8~~

Dated at Antigo, Wis., this 16th day of November, 1969

Signature Raymond J. Hallisy Title Reg. Land Surveyor Registration No. S-685
(County Surveyor, Registered Land Surveyor, or other duly authorized official)

Office of Register of Deeds, County of Antigo, I hereby certify that the within instrument was filed in this office for record on the _____ day of _____, 19____ at _____ o'clock _____ M.

(Register of Deeds)

By _____ Deputy

○ = Corner monument restored.