


U.S. PUBLIC LAND SURVEY MONUMENT RECORD

Note: This form is intended and designed to fulfill all requirements of Wisconsin Administrative Code, Chapter A-E 7.08, U.S. Public Land Survey Monument Record (3) (a) (b) (c) (d) (e) (f) (g) (h) (i). An additional sheet may be added if necessary to conform with said requirements.

(a) Corner location: Township 33 North
 Range 8 East
 Town/City/Village Russell
 County Lincoln

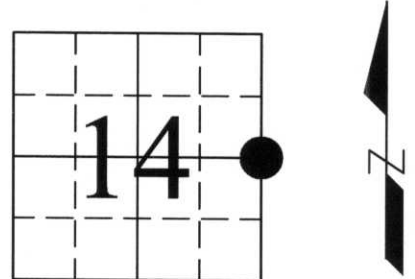

(b) (f) (g) (h) Description of monument found at this corner and if it was accepted, state all evidence (material, testimonial, occupational, plats, records, other monuments) used as a basis for accepting. If not accepted or if nothing was found, state evidence used as basis for establishing location. If reestablished through lost corner proportionate methods, indicate all monuments, distances and directions used to establish.

1854 - JACKSON L. PRENTICE ESTABLISHED QUARTER SECTION POST, WITNESSED BY: TAMARACK 8 N40°W 23 LINKS
 TAMARACK 10 S59°E 36 LINKS

UNKNOWN DATE - UNKNOWN SURVEYOR SET 6"X6" GRANITE MONUMENT.

1997 - DENNIS R. ROBERTS SET BERNTSEN MONUMENT IN CENTERLINE OF DEERSHINERS ROAD AND ON EXTENSION OF OLD FENCE WEST.
 WITNESSED BY: NAIL IN 10" SPRUCE N84°E 115.17 FEET
 NAIL IN 5" RED MAPLE S42°E 49.37 FEET
 NAIL IN 6" RED MAPLE S40°W 64.30 FEET
 1/2" IRON ROD N84°30'W 33.00 FEET

2000 - FOUND 6"X6" GRANITE MONUMENT DOWN 8" FROM ROAD SURFACE. WITNESSED AS SHOWN BELOW.


(c) (d) (e) Plan view of corner with ties to at least 4 witness monuments. If in disagreement with previously established corner, show the distance between the two corners and also indicate the ties to the disputed corner.

● - SET ALUMINUM CAPPED REBAR
 NOT TO SCALE



FOUND BERNTSEN MONUMENT BEARS N42°31'44"E, 1.82 FEET FROM ACTUAL CORNER, FOUND 6"X6" GRANITE MONUMENT.

SET REBAR ON EAST SIDE

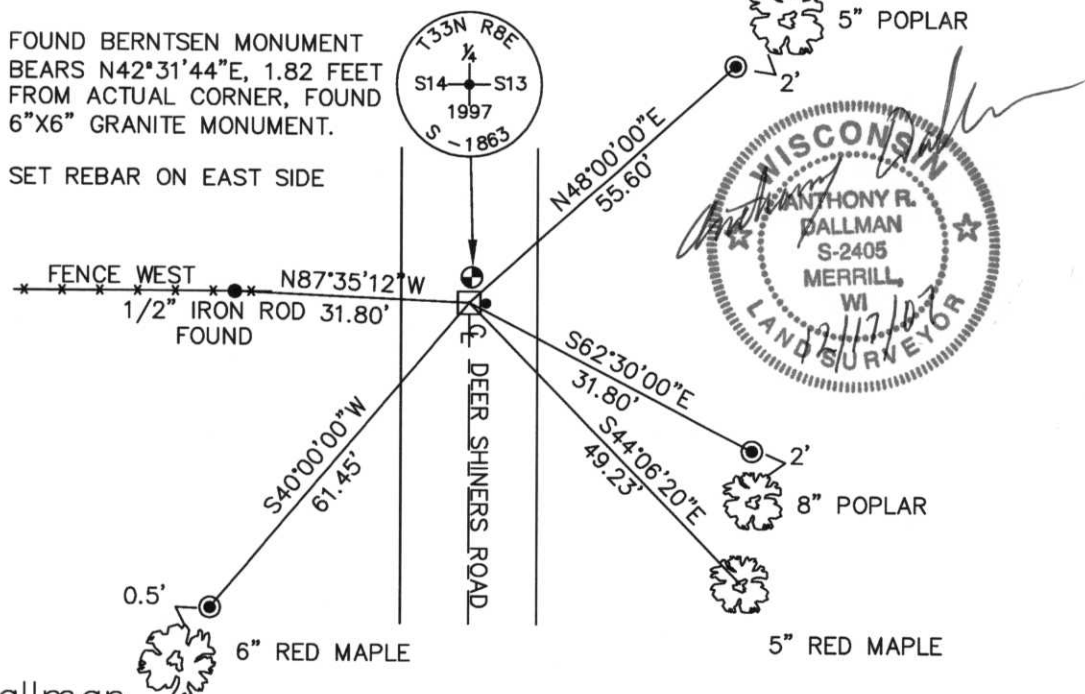

(i) I, Anthony R. Dallman
 (type or print name) certify that the corner location on this record was determined by me or under my direction and control and that this U.S. Public Land Survey Monument Record is correct and complete to the best of my knowledge and belief.

Anthony R. Dallman
 Signature

12/17/07
 Date

Index No. K-21