

CERTIFIED LAND CORNER RESTORATION

Index No. K-13

State of Wisconsin }
County of Lincoln } ss.

History of original corner establishment:

Wood post set by original government surveyor.

I, Sheridan D. Schwark, do hereby certify that on the 26th day of September, 19 80, I found evidence of the W 1/4 corner of Section 15 Township 33, North, Range 8 East, Fourth, Principal Meridian, as described hereon; and that from this evidence I established a new monument and accessories as described hereon to perpetuate the original location of this corner.


Description of corner evidence found:

We found a 6" x 6" red granite monument at a fence intersection. The monument was approximately 4" above grade.


Resident witnesses:

.....
.....
.....

Description of monument and accessories I established to perpetuate the original location of this corner.

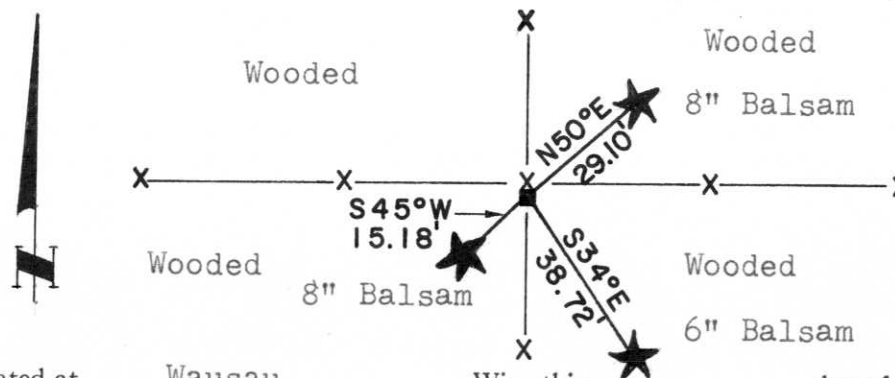

NOTE: All trees are blazed and have P.K. nails with metal discs set in them.

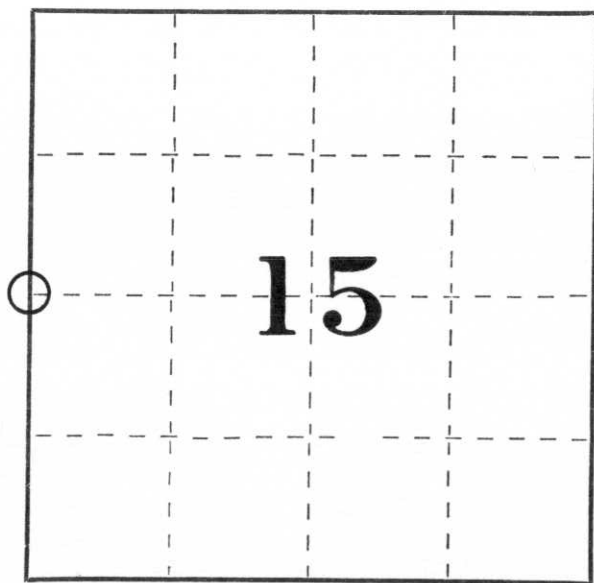

○ = Corner monument restored.

Dated at Wausau, Wis., this day of, 19.....

Signature Sheridan D. Schwark Title Registered Land Surveyor Registration No. S-1205
(County Surveyor, Registered Land Surveyor, or other duly authorized official)

Office of Register of Deeds, County of, I hereby certify that the within instrument was filed in this office for record on the day of, 19..... at o'clock M.

.....
(Register of Deeds)

By Deputy