


CERTIFIED LAND CORNER RESTORATION

Index No. Q-17

State of Wisconsin }
County of Lincoln } ss.

I Sheridan D. Schwark, do hereby certify that on the 9th day of October, 1980, I found evidence of the Northwest corner of Section 26 Township 33 North, Range 8 East, Fourth, Principal Meridian, as described hereon; and that from this evidence I established a new monument and accessories as described hereon to perpetuate the original location of this corner.

Resident witnesses:

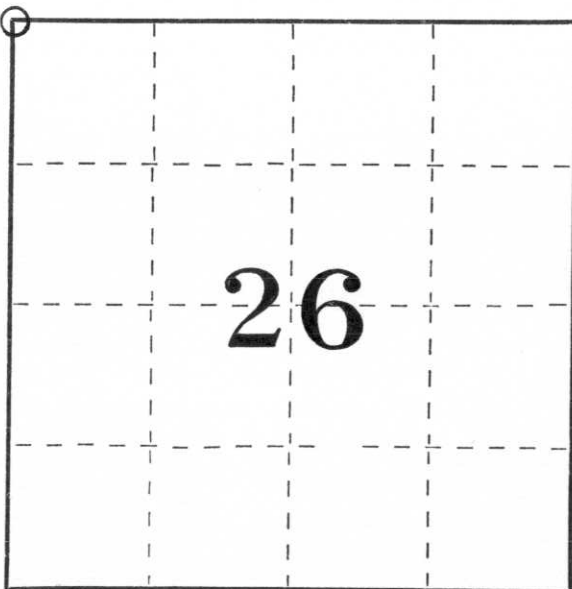


○ = Corner monument restored.

History of original corner establishment:
Wood post by original government surveyor

Description of corner evidence found:

We found a 6" x 6" x 36" granite monument tipped southeasterly. We straightened it and reset it deeper, leaving it up about .5'.

Description of monument and accessories I established to perpetuate the original location of this corner.

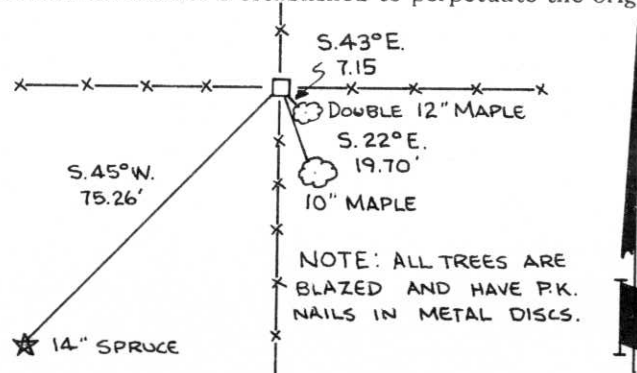

Dated at Merrill, Wis., this 23rd day of October, 1980.

Signature Sheridan D. Schwark Title Registered Land Surveyor Registration No. S-1205
(County Surveyor, Registered Land Surveyor, or other duly authorized official)

Office of Register of Deeds, County of _____, I hereby certify that the within instrument was filed in this office for record on the _____ day of _____, 19____ at _____ o'clock _____ M.

(Register of Deeds)

By _____ Deputy