


CERTIFIED LAND CORNER RESTORATION

Index No. S-25

State of Wisconsin }
County of LINCOLN } ss.

History of original corner establishment:

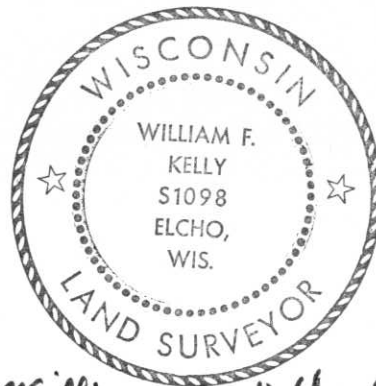



William F. Kelly 9-16-77

I WILLIAM F. KELLY do hereby certify that on the 16TH day of SEPTEMBER, 1977, I found evidence of the 1/4 SECTION corner of SECTIONS 25 & 30 Township 33 North, Range B & 9 E, Fourth, Principal Meridian, as described hereon; and that from this evidence I established a new monument and accessories as described hereon to perpetuate the original location of this corner.

Description of corner evidence found:
CORNER PROPORTIONED FROM ORIGINAL NOTES BETWEEN THE N.E. CORNER AND S.E. CORNER STONES FOUND IN PLACE.
STONE MONUMENT SET IN 1920'S RESURVEY DESTROYED BY ROAD WORK.

Resident witnesses:

Description of monument and accessories I established to perpetuate the original location of this corner.

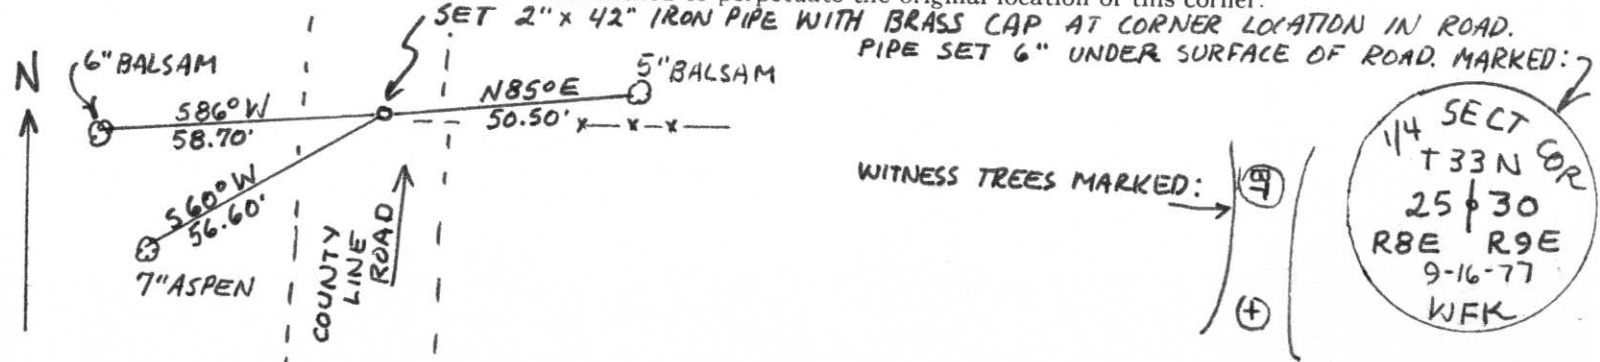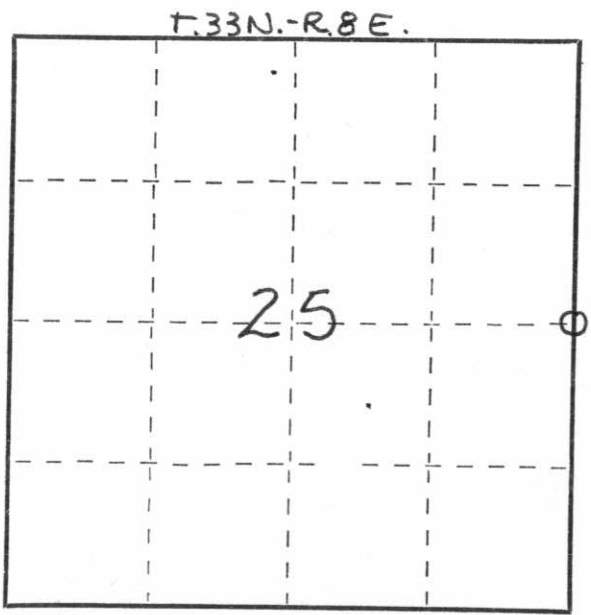

Dated at ELCHO, Wis., this 16TH day of SEPTEMBER, 1977.

Signature William F. Kelly Title REGISTERED LAND SURVEYOR Registration No. S1098
(County Surveyor, Registered Land Surveyor, or other duly authorized official)

Office of Register of Deeds, County of _____, I hereby certify that the within instrument was filed in this office for record on the _____ day of _____, 19____ at _____ o'clock _____ M.

(Register of Deeds)

By _____ Deputy

○ = Corner monument restored.

U.S. PUBLIC LAND SURVEY MONUMENT RECORD


43308252000

HISTORY OF ORIGINAL CORNER ESTABLISHMENT AND SUBSEQUENT RESTORATION AND DESCRIPTION OF ANY RECORD, MONUMENT OCCUPATIONAL, TESTIMONIAL OR OTHER EVIDENCE CONSIDERED:

The original corner was established in 1851 by James M. Marsh. Original Bearing Trees: Birch 10" S23E 17lks., Birch 10" S50W 13lks., Birch 11" N29E 20lks., Hemlock 9" N31W 47lks. In 1902, Webley found an original BT standing and set a grey boulder 10x14x20 with a cross on top, and a new BT: 14" Maple N731/2E 64 lks. On 8/7/2002, Gerry Bahar visited the 1/4 corner location and found no corner monumentation. We located an East-West Fence and set a 1.25" rod where the fence intersected centerline of County Line Road.

E 1/4 25-33-8

● = LOCATION OF CORNER

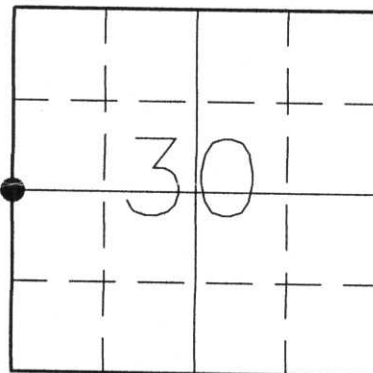


SECTION 30
TOWNSHIP 33 NORTH, RANGE 09 EAST
TOWN OF SUMMIT
LANGLADE COUNTY, WISCONSIN

CORNER WAS: (CHECK ALL THAT APPLY)

- RESTORED THROUGH ACCEPTANCE OF AN OBLITERATED EVIDENCE LOCATION
- RESTORED THROUGH ACCEPTANCE OF A FOUND PERPETUATED LOCATION
- CONSIDERED A LOST CORNER AND REESTABLISHED THROUGH LOST CORNER PROPORTIONATE METHODS (INCLUDE A PLAN VIEW DRAWING SHOWING DISTANCES AND DIRECTIONS TO OTHER PUBLIC LAND SURVEY CORNERS USED FOR PROPORTIONING AND DETERMINING THE CORNER LOCATION)
- RESTORED OR REESTABLISHED IN A LOCATION THAT DIFFERS FROM A PREVIOUS RESTORATION OR REESTABLISHMENT (INCLUDE A PLAN VIEW DRAWING AND INDICATE WHAT WAS SET AND/OR FOUND)
- CHECK IF THERE IS ADDITIONAL INFORMATION ON BACK

DESCRIBE THE MONUMENT AND ACCESSORIES USED TO PERPETUATE THE LOCATION OF THE CORNER. (INCLUDE A PLAN VIEW DRAWING AND INDICATE WHAT WAS SET AND/OR FOUND) ALSO INCLUDE FOUR TIES TO THE SECTION CORNER AND DESCRIPTION OF THE TIES.

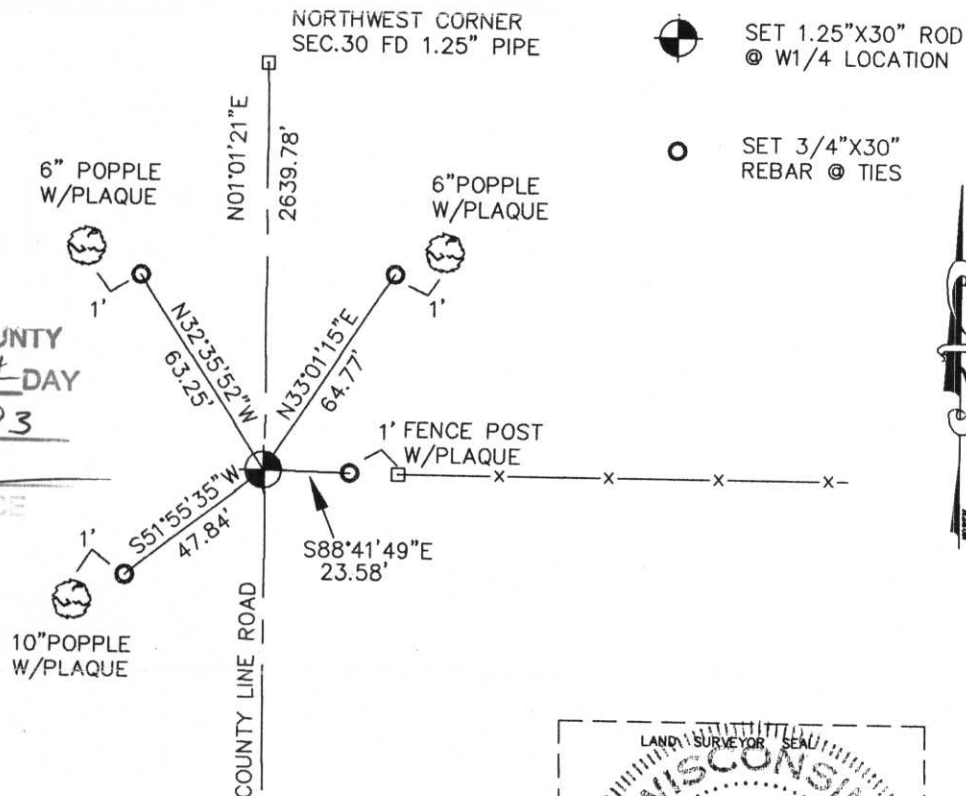

RECEIVED AT LINCOLN COUNTY
COURTHOUSE THIS 18TH DAY
OF June 20 03
Tony Dulla
LAND INFORMATION OFFICE

DANIEL E. HIGGINBOTHAM

(Type or print name) CERTIFY THAT THE CORNER LOCATION SHOWN ON THIS RECORD WAS DETERMINED BY ME OR UNDER MY DIRECTION AND CONTROL AND THAT THIS U.S. PUBLIC LAND SURVEY MONUMENT RECORD IS CORRECT AND COMPLETE TO THE BEST OF MY KNOWLEDGE AND BELIEF.

Daniel E. Higginbotham
SIGNATURE DATE 2/12/03



INDEX NO. 60-EE
5-25