


# U.S. PUBLIC LAND SURVEY MONUMENT RECORD

Note: This form is intended and designed to fulfill all requirements of Wisconsin Administrative Code, Chapter A-E 7.08 U.S. Public Land Survey Monument Record (3)(a)(b)(c)(d)(e)(f)(g)(h)(i). An additional sheet may be added if necessary to conform with said requirements.

(a) Corner location: Township 33 North  
 Range 08 East West

Town/City/Village RUSSELL  
 County LINCOLN

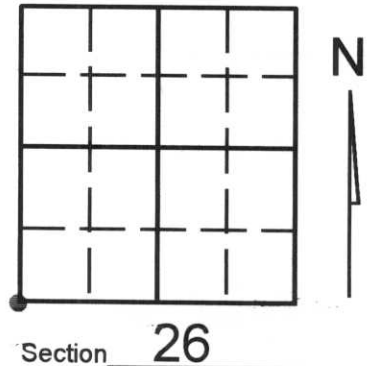

(b) (f) (g) (h) Description of monument found at this corner and if it was accepted, state all evidence (material, testimonial, occupational, plats, records, other monuments) used as a basis for accepting. If not accepted or if nothing was found, state evidence used as basis for establishing location. If reestablished through lost corner proportionate methods, indicate all monuments, distances and directions used to establish. Indicate type of monument found or set and sign post.


-GOV'T SURVEYOR- SET SECTION POST AND NOTED THE FOLLOWING B.T.s:  
 BIRCH, ELM AND TAMARACK (NO DIMENSIONAL DATA NOTED)

- 2000 - KEVIN BIXBY SET P.K. NAIL AND WITNESS AS SHOWN BELOW.  
 CORNER LOCATION WAS ACCEPTED BY LOCAL TESTIMONY

RECEIVED AT LINCOLN COUNTY  
 COURTHOUSE THIS 25<sup>TH</sup> DAY  
 OF September 20 00  
*Tony Dellman*  
 LAND INFORMATION OFFICE

(c) (d) (e) Plan view of corner with ties to at least 4 witness monuments. If in disagreement with previously established corner, show the distances between the two corners and also indicate the ties to the disputed corner.

NOTE: BEARINGS AND DISTANCES MEASURED WITH TOTAL STATION. NO SCALE.

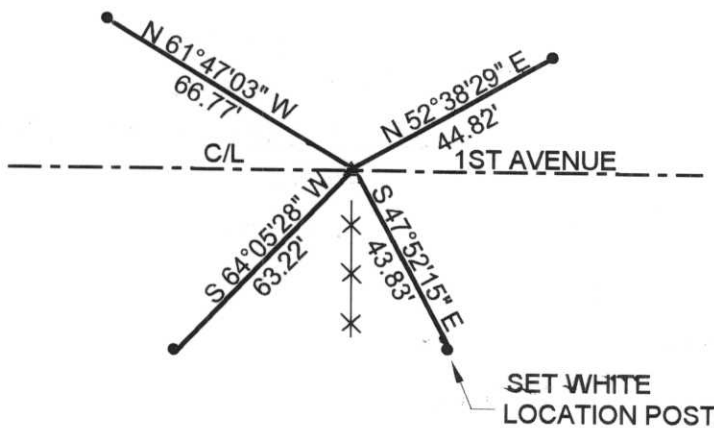

LEGEND

- ▲ SET P.K. NAIL
- SET LINCOLN COUNTY WITNESS MONUMENT
- \*\*\* EXISTING BARBED WIRE FENCE



(i) I, KEVIN P. BIXBY

(type or print name) certify that the corner location on this record was determined by me or under my direction and control and that this U.S. Public Land Survey Monument Record is correct and complete to the best of my knowledge and belief.



Index No. C-17

*Kevin P. Bixby*  
 Signature

09/20/00  
 Date