

CERTIFIED LAND CORNER RESTORATION


Index No. U-5

State of Wisconsin }  
County of Lincoln } ss.

I Lester J. Schmit, do hereby  
certify that on the 4th day  
of June, 1982, ~~found~~  
~~evidence of the~~ I set the Northeast  
corner of Section 31  
Township 33, North, Range  
8 East, Fourth, Principal Meridian,  
as described hereon; and that from this evidence  
I established a new monument and accessories  
as described hereon to perpetuate the original  
location of this corner.

Resident witnesses:

Clarence Montabon  
\_\_\_\_\_  
\_\_\_\_\_  
\_\_\_\_\_

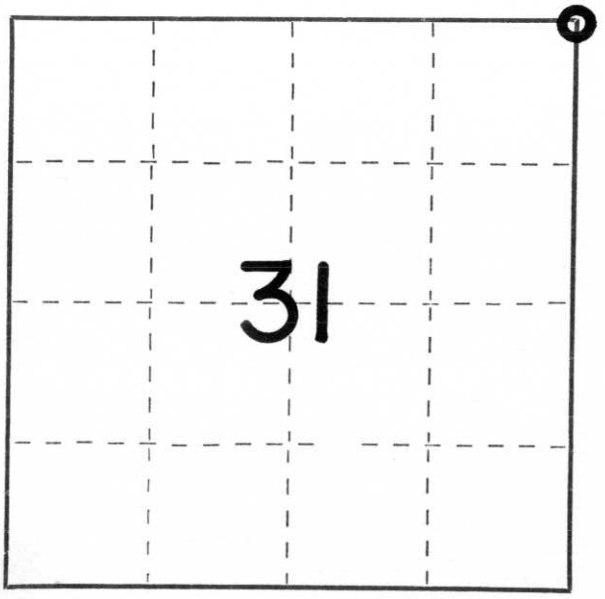

○ = Corner monument restored.

History of original corner establishment:

Surveyor: Jackson L. Prentice  
Date: 11 October 1854  
Monumentation: Wood Post  
Witnesses: Balsm 10", N 85° W, 3.40 links  
Balsm 10", S 80° W, 3.30 links  
Balsm 8", S 51° E, 25 links  
Balsm 10", N 36° E, 43 links

Description of corner evidence found: The corner location was destroyed when a new bridge was constructed over the North Branch of the Prairie River. Clarence Montabon who operated the road grater for the Town of Russell for many years, remembers seeing a portion of the granite monument (the section corner) while the new bridge was under construction. Using his witness that the corner was in a westerly extention of the centreline of Prairie Forks Drive and using a 1" iron rebar (approximate Northwest corner of Volume 245 at page 197), we measured Easterly the called distance of 400.00' and place the corner at the intersection of these two references.

Description of monument and accessories I established to perpetuate the original location of this corner.

30" Berntsen monument set flush with road surface, 12' west to left bank.

Witnesses: P.K. nail in 20" White Spruce, N 33° E, 60.60'  
P.K. nail in power pole # 3308-30R1, N 53° E, 61.85'  
P.K. nail in power pole # 3308-32W3, S 22° E, 108.78'  
1" iron pipe on section line, S 89° W, 69.70'

Dated at Tomahawk, Wis., this 9th day of June, 1982.

Signature \_\_\_\_\_ Title Land Surveyor Registration No. S-1192  
(County Surveyor, Registered Land Surveyor, or other duly authorized official)

Office of Register of Deeds, County of \_\_\_\_\_, I hereby certify that the within  
instrument was filed in this office for record on the \_\_\_\_\_ day of \_\_\_\_\_, 19\_\_\_\_  
at \_\_\_\_\_ o'clock \_\_\_\_\_ M.

\_\_\_\_\_  
(Register of Deeds)

By \_\_\_\_\_ Deputy