
U.S. PUBLIC LAND SURVEY MONUMENT RECORD

This form is intended and designed to fulfill all requirements of Wisconsin Administrative Code, Chapter A-E 5.02, U.S. Public Land Survey Mondanian Conform with said requirements.

Township 32 North Public Land Survey Monument Record (3) (a) (b) (c) (d) (e) (f) (g) (h) (i). An additional sheet may be added if necessary to (a) Corner location: Township_ Range 8 East

SCHLEY Town/City/Village -LINCOLN County ____

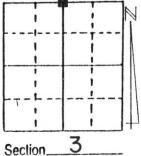


(b) (f) (g) (h) Description of monument found at this corner and if it was accepted, state all evidence (material, testimonial, occupational, plats, records, other monuments) used as a basis for accepting. If not accepted or if nothing was found, state evidence used as basis for establishing location. If reestablished through lost corner proportionate methods, indicate all monuments, distances and directions used to establish.

History of original corner: wood post set by Frederick Ellis in 1852 Witnesses: 12" Hemlock, N78°E, 40 links, 10" Hemlock, S38°E, 12 links 12" Hemlock, S62°W, 12links; 12" Hemlock N89°W, 13 links

We dug at the extension of an old fence line from the north and the centerline of C.T.H. "J". This was a fill area of the road through a swamp. We dug down 8± feet and hit logs layed across road bed and could not dig any farther without destroying road base. Used a straight line single proportion between the NW corner and the NE corner. This fit the old fence to the north and the centerline of C.T.H. "J". Set Lincoln County Berntsen Monument 1' foot below road surface and tied out as shown below.

(c) (d) (e) Plan view of corner with ties to at least 4 witness monuments. If in disagreement with previously established corner, show the distances between the two corners and also indicate the ties to the disputed corner.

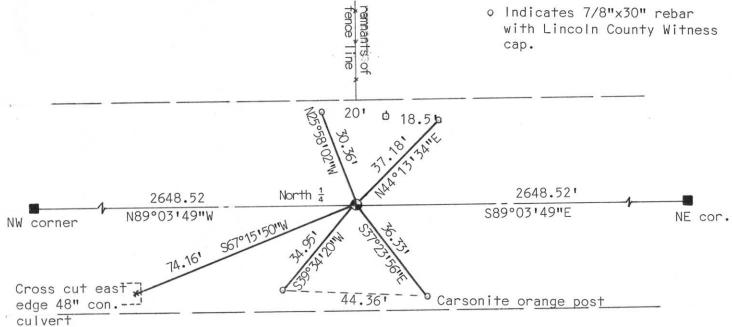

David J. Goslin RLS No. s-2280 (type or print name) certify that the corner location on this record was determined by me or under my direction and control and that this U.S. Public Land Survey Monument Record is correct and

complete to the best of my knowledge and belief.

Signature Date

