

LINCOLN COUNTY U.S. PUBLIC LAND SURVEY MONUMENT LOCATION RECORD

SECTION 3
TOWNSHIP 34 N
RANGE 4 E

E-17
NO.

LANDMARK BENCHMARK
CORNER IDENTITY: BERNTSEN SNM1 STEEL NAIL MARKER
FOUND
SET
RESET
RE-TIED

LINCOLN COUNTY COORDINATE: N: 222086.816
E: 322893.655


ELEVATION-(FEET): _____ DATUM: 83 (2011)

WEATHER: P. CLOUDY

DATE OF SURVEY: 07/18/2019 TEMPERATURE: 80 °F

SURVEY PARTY: KEITH WALKOWSKI AND AUSTIN PELOT

TOMAHAWK
CITY, VILLAGE, TOWN

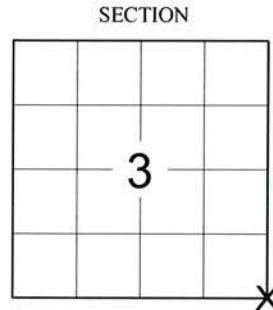

LOCATION
(Indicated By)



BASIS FOR MONUMENT LOCATION:

(DESCRIBE METHOD OF SURVEY AND CORNER AUTHENTICATION)

SEARCHED FOR THE TIES FOR THE SOUTHEAST CORNER OF SECTION 3 BEFORE THE START OF THE RESURFACING PROJECT ON HWY "86" AND FOUND ALL 4 TIES FROM THE 1991 TIE SHEET BY R.B. JOHNSON BUT DID NOT FIND A CORNER MONUMENT. INTERSECTED THE TIES TO SET A BERNTSEN SNM1 STEEL NAIL MARKER ALONG WITH 2 ADDITIONAL TIES AFTER COMPLETION OF RESURFACING PROJECT TO PERPETUATE THE CORNER LOCATION AS SHOWN BELOW.

FIELD BOOK NO. NA PAGE NO. NA

COMPANY RIVERSIDE LAND SURVEYING LLC

CERTIFIED CORRECT:

Keith J. Walkowski


KEITH J. WALKOWSKI S-2717
Professional Land Surveyor

DATE: OCTOBER 15TH, 2019

TIE SKETCH:

- SET BERNTSEN SNM1 STEEL NAIL MARKER
- FOUND RED CAPPED 5/8" REBAR
- SET BERNTSEN SSSDR-130
- SET VINYL "T" POST

RECEIVED BY LINCOLN COUNTY
SURVEYOR THIS 12TH DAY
OF November 20 19
Tom Dahl
COUNTY SURVEYOR

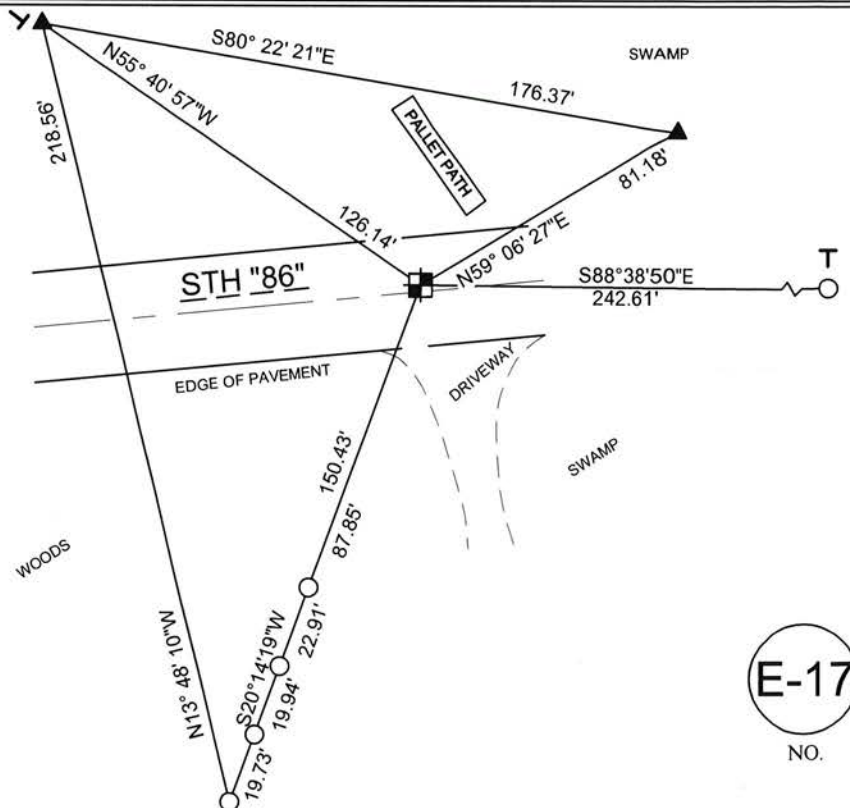

NOTE: CORNER LIES 1.9' NORTH OF CENTERLINE

BEARINGS ARE BASED ON THE LINCOLN COUNTY COORDINATE SYSTEM NAD 83 (2011) AND REFERENCED AS SHOWN

THIS DRAWING IS NOT TO SCALE

E-17
NO.



RECORD AND CERTIFICATION OF U.S.
PUBLIC LAND SURVEY CONTROL STATION

E-D-716-72

State of Wisconsin / Department of Transportation

District 7	Project I. D. 9215-06-00	Located by R.B. JOHNSON - SURVEY CREW CHIEF			
Corner S.E. Cor.	3 SECTION	Township 34 N	Range (E,W) 4 E	County LINCOLN	
Wisconsin Coordinates CORNER	East (X) 2,010,370.72	North (Y) 590,603.61	Elevation (Z)	Zone C	
Control Station Name	East (X)	North (Y)	Elevation (Z)	Zone	
Horizontal — NORTH AMERICAN, 1927		CONTROL DATUM Vertical — MEAN SEA LEVEL, 1929 ADJUSTMENT			
Horizontal — 2nd Order		SURVEY CONTROL Vertical — _____ Order			

SKETCH

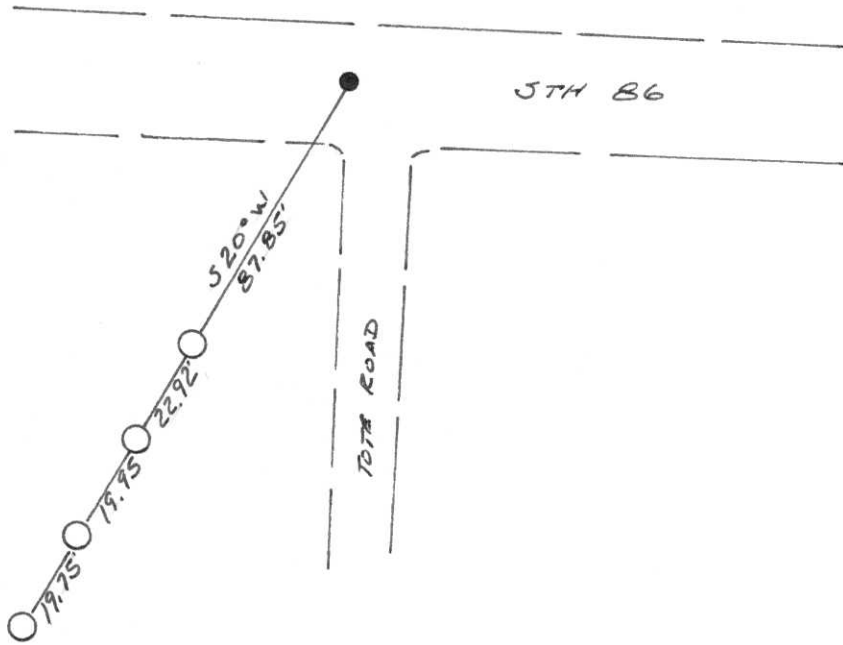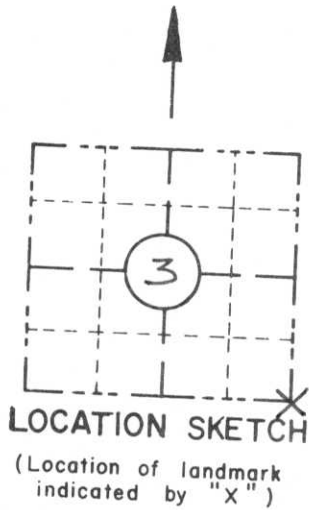

I hereby certify that on the 2nd day of APRIL 1991, that I did locate the above corner which was evidenced by 1/4" IRON PIPE

_____ ; I further certify that to perpetuate the location of such corner I did, at the exact location thereof, place a permanent marker consisting of _____

_____ ; I further certify that I did establish 4 references or witness monuments consisting of 5/8" x 24" RE-BARS WITH RED PLASTIC D.O.T. CAPS

_____ located as shown above:

SEAL

Signature Registered Land Surveyor	Registration No. S--	Title
------------------------------------	-------------------------	-------

CORNER
S.E. Cor.
SECTION
3
TOWN
34 N
RANGE
4 E

FIELD SURVEY NOTES

E-D-702 6-70


State of Wisconsin / Department of Transportation

CORNER
E17 T34N-R4E
1/4" IRON BAR

APRIL 2 1991
RBJ, SM, GS



150.470	62.625	39.700
<u>62.625</u>	<u>39.700</u>	<u>19.745</u>
87.845	22.925	19.955

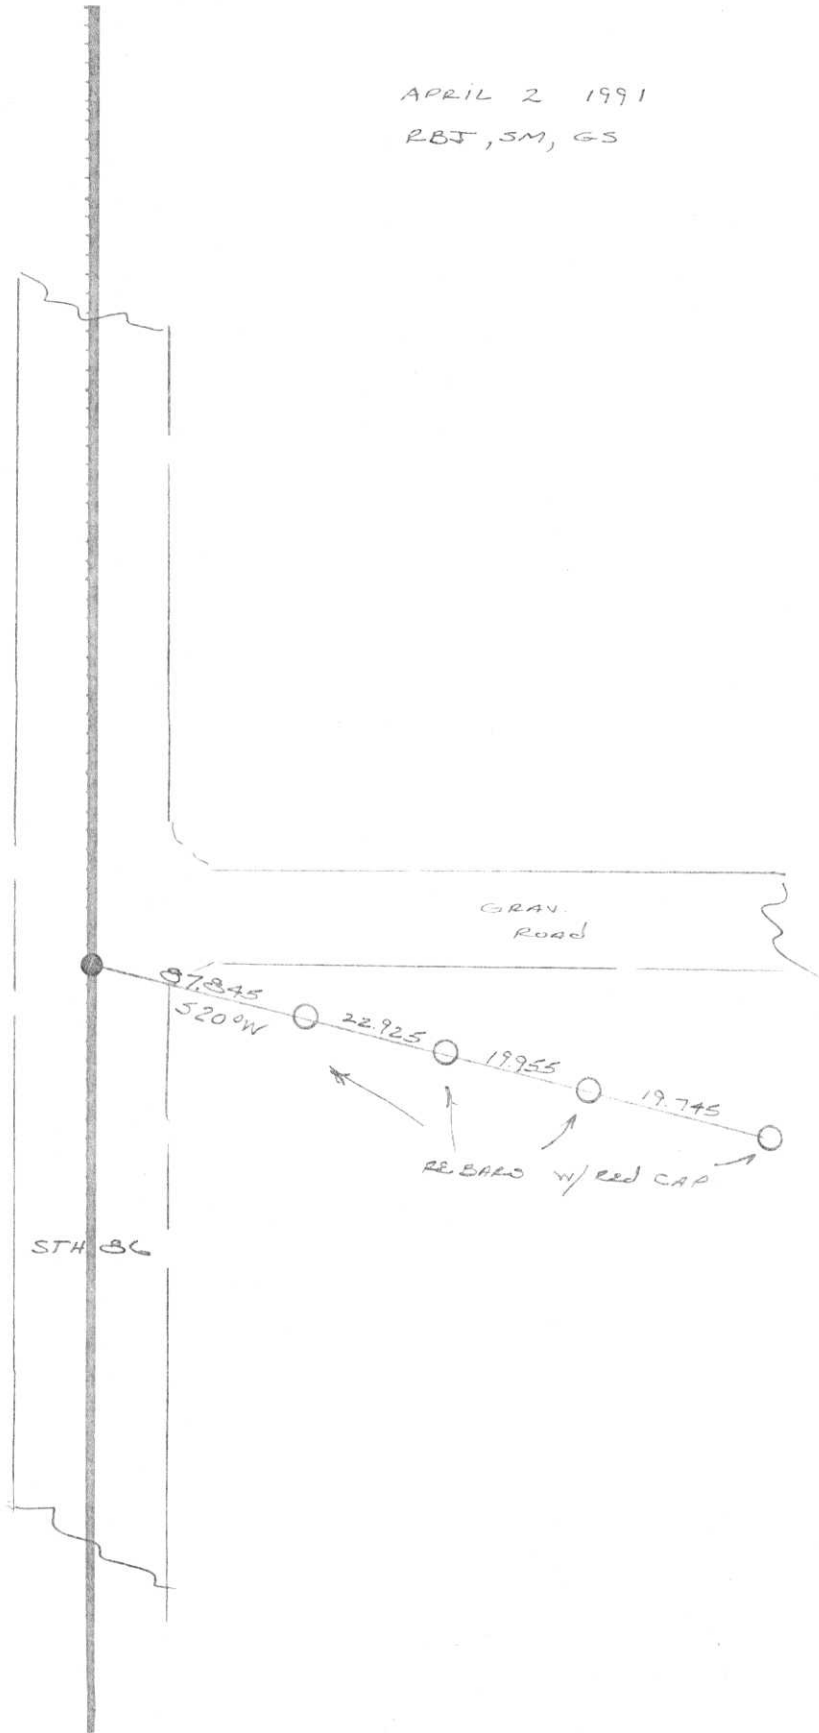

- TOPOGRAPHY
- SURVEY ALIGNMENT

E-11

RECEIVED JUN 18 1991

FIELD SURVEY NOTES


E-D-702 6-70

NE Sec 10
T34N R4E

State of Wisconsin / Department of Transportation

CORNER
E 17 T34N-R4E
1/2" IRON BAR

APRIL 2 1991
RBJ, SM, GS

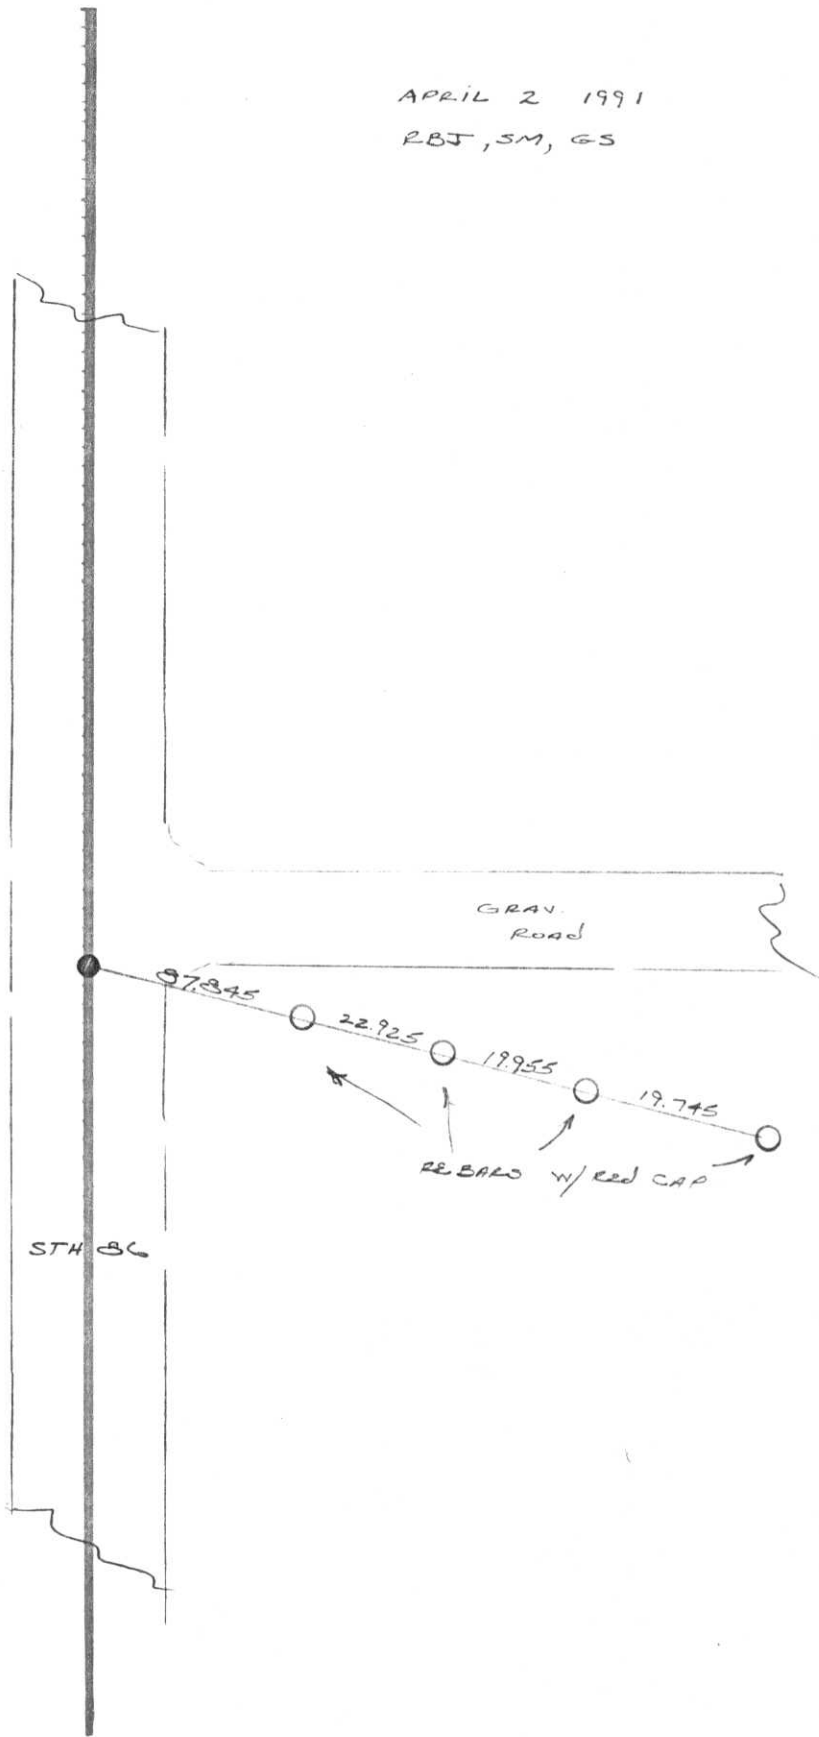

150.470	62.625	39.700
62.625	39.700	19.745
87.845	22.925	19.955

- TOPOGRAPHY
- ALIGNMENT

CERTIFIED LAND CORNER RESTORATION

Index No. E-17

State of Wisconsin }
 County of LINCOLN } ss.

I DAVID L. HENKE, do hereby certify that on the 14th day of NOVEMBER, 1988, I found evidence of the NORTHWEST corner of SECTION 11 Township 34, North, Range 4 EAST, Fourth Principal Meridian, as described hereon; and that from this evidence I established a new monument and accessories as described hereon to perpetuate the original location of this corner.

Resident witnesses:


.....

.....


.....

History of original corner establishment:


Description of corner evidence found:
1 1/4" IRON BAR FOUND CENTER OF HWY 86
FOUND 3/4" IRON PIPES N+S AT 34'
FOUND GREEN/WHITE POST 35' SOUTH

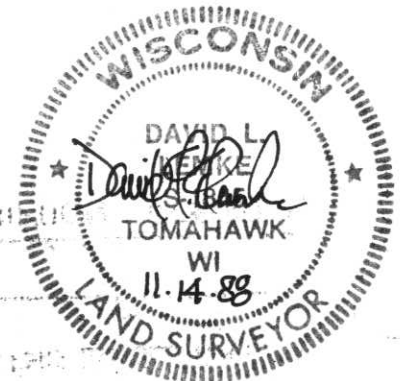

Description of monument and accessories I established to perpetuate the original location of this corner.

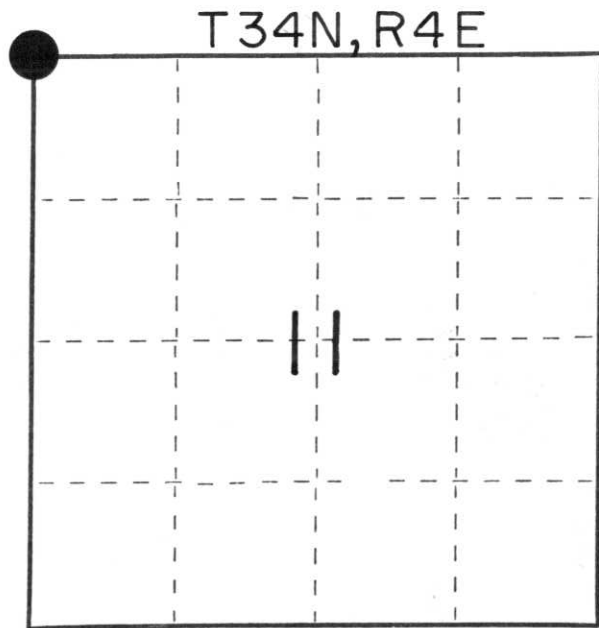

○ = Corner monument restored.

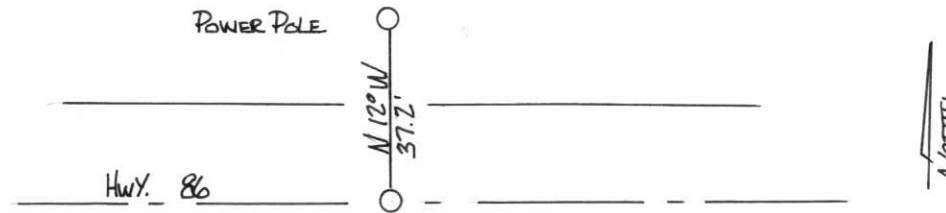

Dated at TOMAHAWK, Wis., this 16 day of NOVEMBER, 1988

Signature: David Henke Title: REGISTERED LAND SURVEYOR Registration No. S-1845
 (County Surveyor, Registered Land Surveyor, or other duly authorized official)

Office of Register of Deeds, County of....., I hereby certify that the within instrument was filed in this office for record on the.....day of....., 19..... at.....o'clock..... M.

.....
 (Register of Deeds)

By.....Deputy

Stock No. 26272



FORM 985