

LINCOLN COUNTY U.S. PUBLIC LAND SURVEY MONUMENT LOCATION RECORD

SECTION 9
TOWNSHIP 34 N
RANGE 4 E

E-11
NO.

LANDMARK BENCHMARK _____
CORNER IDENTITY: BERNTSEN SNM1 STEEL NAIL MARKER

FOUND
SET
RESET
RE-TIED

LINCOLN COUNTY COORDINATE: N: 221977.302
E: 315017.942


ELEVATION-(FEET): _____ DATUM: 83 (2011)

WEATHER: P. CLOUDY

DATE OF SURVEY: 07/25/2019 TEMPERATURE: 80 °F

SURVEY PARTY: KEITH WALKOWSKI AND AUSTIN PELOT

TOMAHAWK
CITY, VILLAGE, TOWN

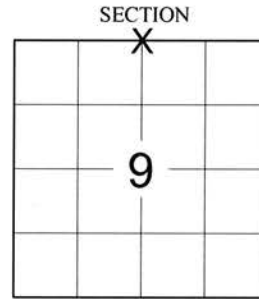

LOCATION
(Indicated By X)



BASIS FOR MONUMENT LOCATION:
(DESCRIBE METHOD OF SURVEY AND CORNER AUTHENTICATION)

SEARCHED FOR THE NORTH 1/4 CORNER OF SECTION 9 BEFORE THE START OF THE RESURFACING PROJECT ON HWY "86" AND FOUND ALL 4 TIES ALONG WITH A SMP NAIL FROM THE 2015 TIE SHEET BY ANTHONY DALLMAN. SET A BERNTSEN SNM1 STEEL NAIL MARKER AT THE CORNER ALONG WITH ADDING AN ADDITIONAL TIE UPON COMPLETION OF THE STH 86 RESURFACING PROJECT TO PERPETUATE THE CORNER LOCATION AS SHOWN BELOW.

FIELD BOOK NO. NA PAGE NO. NA

COMPANY RIVERSIDE LAND SURVEYING LLC

CERTIFIED CORRECT:

Keith J. Walkowski


KEITH J. WALKOWSKI S-2717
Professional Land Surveyor

DATE: OCTOBER 15TH, 2019

TIE SKETCH:

- SET BERNTSEN SNM1 STEEL NAIL MARKER
- - FOUND ALUMINUM CAPPED 7/8" REBAR
- ⊙ - FOUND 5/8" CAPPED REBAR
- - FOUND MAG NAIL IN POWER POLE
- T - SET VINYL "T" POST
- ▲ - SET BERNTSEN SDDR-130

RECEIVED BY LINCOLN COUNTY
SURVEYOR THIS 12TH DAY
OF November 20 19
Tony Dahl
COUNTY SURVEYOR

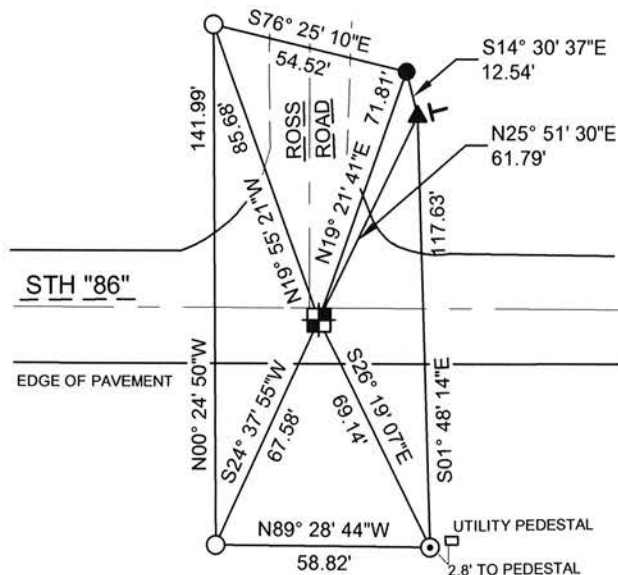

NOTE: CORNER LIES 3.35' SOUTH OF CENTERLINE

BEARINGS ARE BASED ON THE LINCOLN COUNTY COORDINATE SYSTEM NAD 83 (2011) AND REFERENCED AS SHOWN

THIS DRAWING IS NOT TO SCALE

E-11
NO.

U.S. PUBLIC LAND SURVEY MONUMENT RECORD

NOTE: THIS FORM IS INTENDED AND DESIGNED TO FULFILL ALL REQUIREMENTS OF WISCONSIN ADMINISTRATIVE CODE, CHAPTER A-E 7.08, U.S. PUBLIC LAND SURVEY MONUMENT RECORD (3)(a)(b)(c)(d)(e)(f)(g)(h)(i). ADDITIONAL SHEETS MAY BE NECESSARY TO CONFORM TO SAID REQUIREMENTS.


T 34 N, R 4 E

(a) CORNER LOCATION:

NORTH QUARTER CORNER, SECTION 9
 TOWNSHIP 34 NORTH
 RANGE 4 EAST
 TOWN OF TOMAHAWK
 LINCOLN COUNTY
 WISCONSIN

(b) HISTORY OF ORIGINAL CORNER:

ORIGINAL SURVEYOR: Edward D. Palmer, Set post
 COMMENCING DATE: April 10, 1865
 COMPLETION DATE: April 20, 1865
 ORIGINAL BEARING TREES:
 9" Hemlock; N 20° W; 20 links
 6" Fir; S 35° E; 5 links

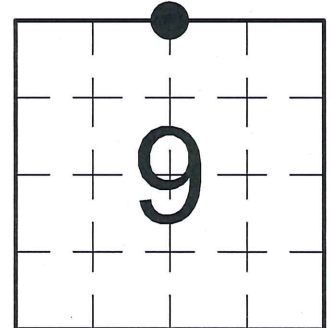

(f)(g)(h) DESCRIPTION OF MONUMENT FOUND AT THIS CORNER AND IF IT WAS ACCEPTED. STATE ALL EVIDENCE (MATERIAL, TESTIMONIAL, OCCUPATIONAL, PLATS, RECORDS, OTHER MONUMENTS) USED AS A BASIS FOR ESTABLISHING LOCATION. IF RE-ESTABLISHING THROUGH LOST CORNER PROPORTIONATE METHODS, INDICATE ALL MONUMENTS, DISTANCES, AND DIRECTIONS USED TO ESTABLISH. INDICATE TYPE OF MONUMENTS FOUND OR SET.

08/02/1974 - W. Kelly, RLS-1098, found no monumentation at the corner location. He found a 4" x 4" Wood Post scribed as a "Witness Corner" 33' south. He set a Berntsen Aluminum Monument 33' north of the Wood Post, 1/2" below the asphalt road surface of State Highway "86". He made reference ties to perpetuate the corner location.


04/02/1991 - R. Johnson, WisDOT survey crew chief, found the Berntsen Aluminum Monument and set new reference ties to further perpetuate the corner location.

07/24/2013 - I, Anthony R. Dallman, PLS-2405, found no monumentation at the corner location. The only remaining reference tie found intact was the SE tie from 1991. I used the record distance from said reference tie and held an equal distance from the NW and NE section corner, Section 9. I set new reference ties to further perpetuate the corner location, as shown in the sketch below.

(c)(d)(e) PLAN VIEW OF THE CORNER WITH TIES TO AT LEAST FOUR WITNESSES. IF IN DISAGREEMENT WITH PREVIOUSLY ESTABLISHED CORNER, SHOW THE DISTANCES BETWEEN THE TWO CORNERS AND ALSO THE TIES TO THE DISPUTED CORNER.




- Tie bearings by hand-held compass.
- Tie distances by steel tape.

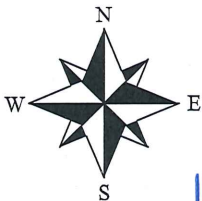

Anthony R. Dallman

 ANTHONY R. DALLMAN
 S-2405
 MERRILL, WI
 7/31/15

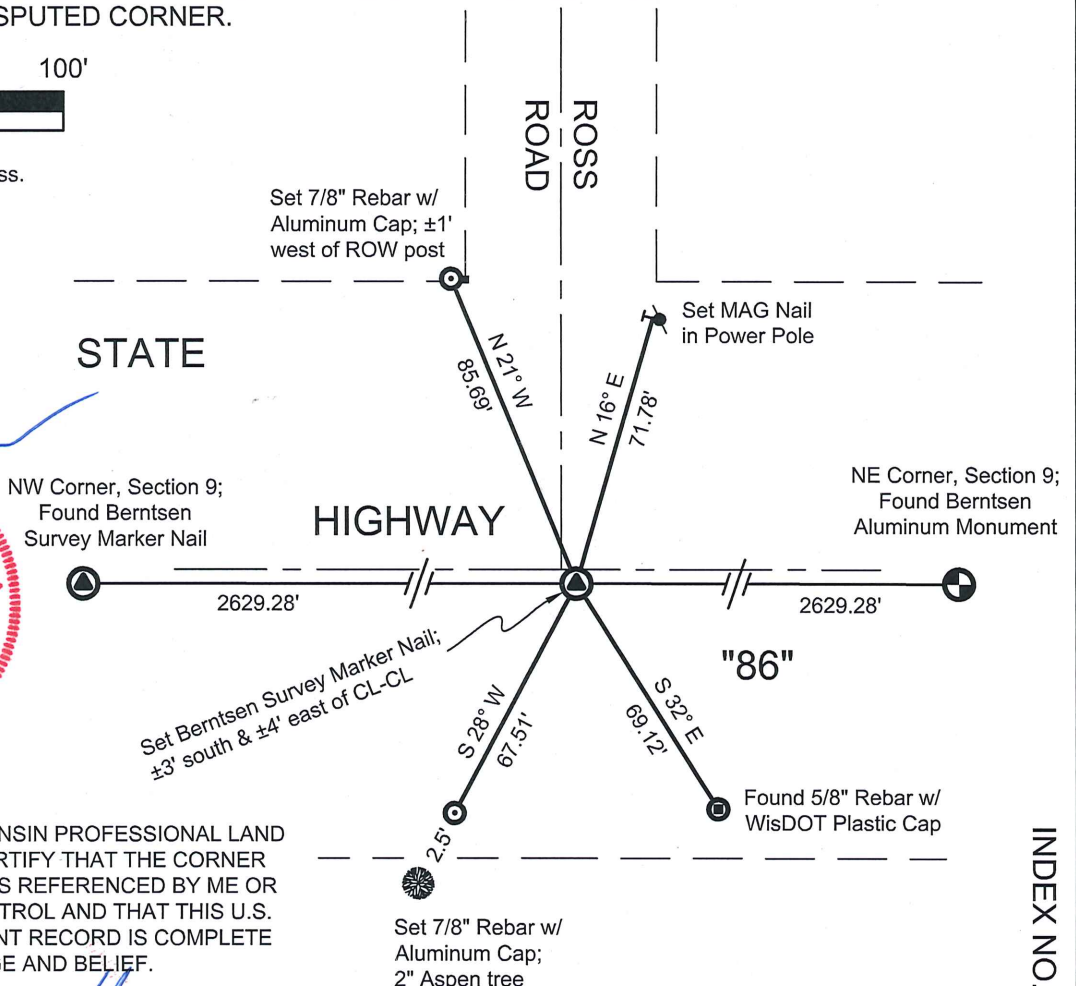

I, ANTHONY R. DALLMAN, WISCONSIN PROFESSIONAL LAND SURVEYOR, S-2405, HEREBY CERTIFY THAT THE CORNER LOCATION ON THIS RECORD WAS REFERENCED BY ME OR UNDER MY DIRECTION AND CONTROL AND THAT THIS U.S. PUBLIC LAND SURVEY MONUMENT RECORD IS COMPLETE TO THE BEST OF MY KNOWLEDGE AND BELIEF.

Anthony R. Dallman 7/31/15
 ANTHONY R. DALLMAN, PLS S-2405

INDEX NO. E-11



RECORD AND CERTIFICATION OF U.S.
PUBLIC LAND SURVEY CONTROL STATION

State of Wisconsin / Department of Transportation

E-D-716-72

| | | | | | |
|-----------------------------------|-----------------------------|--|--|-------------------|--|
| District 7 | Project I. D. 9215-05-00 | Located by R.B. JOHNSON - SURVEY CREW CHIEF | | | |
| Corner 5/4 | 4 SECTION | Township 34 N | Range (E,W) 4 E | County LINCOLN | |
| Wisconsin Coordinates CORNER | East (X) 2,002,495.95 | North (Y) 590,468.20 | Elevation (Z) | Zone C | |
| Control Station Name | East (X) | North (Y) | Elevation (Z) | Zone | |
| Horizontal — NORTH AMERICAN, 1927 | CONTROL DATUM | | Vertical — MEAN SEA LEVEL, 1929 ADJUSTMENT | | |
| Horizontal — 2ND Order | SURVEY CONTROL | | Vertical — _____ Order | | |

SKETCH

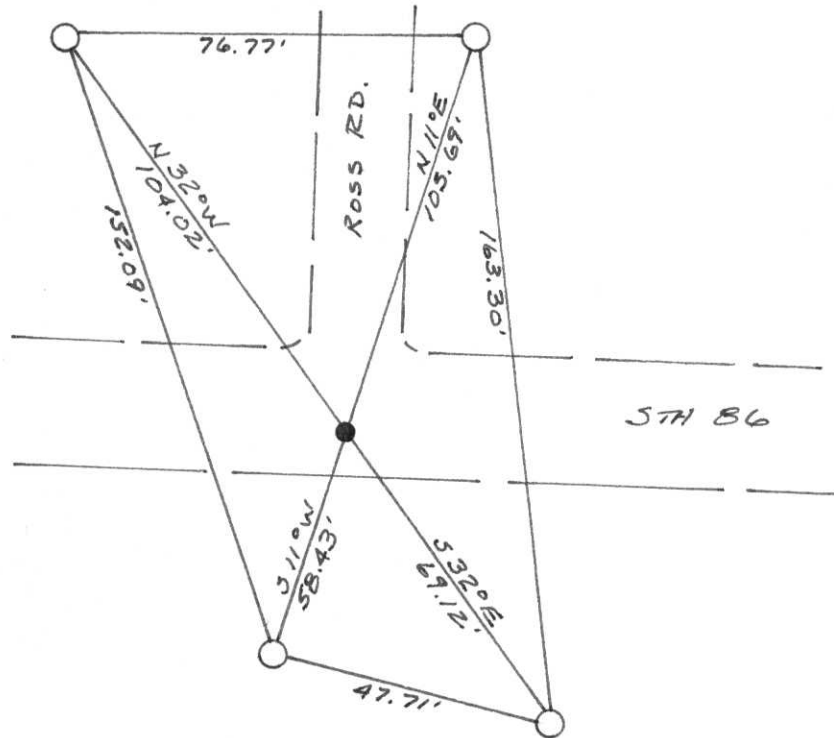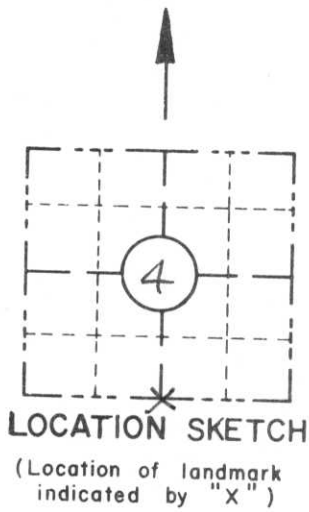

I hereby certify that on the 2ND day of APRIL 1991, that I did locate the above corner which was evidenced by BERNTSEN ALUMINUM MONUMENT; I further certify that to perpetuate the location of such corner I did, at the exact location thereof, place a permanent marker consisting of _____

_____ ; I further certify that I did establish 4 references or witness monuments consisting of 5/8" x 24" RE-BALS WITH RED PLASTIC D.O.T. CAPS

_____ located as shown above:

SEAL

| | | |
|------------------------------------|-------------------------|-------|
| Signature Registered Land Surveyor | Registration No. S-- | Title |
|------------------------------------|-------------------------|-------|

CORNER
5/4
SECTION
4
TOWN
34 N
RANGE
4 E

E-1

E-11

FIELD SURVEY NOTES

E-D.702 6-70

RECEIVED JUN 18 1991


N 1/4 Sec 9
T34N R4E

State of Wisconsin / Department of Transportation

APRIL 2 1991

RBJ SM GS

CORNER
E 11 T34N-R4E
BERNSTEIN MON.

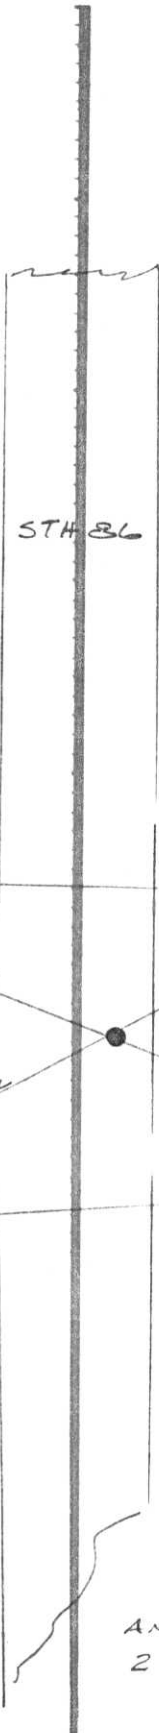

164.120 173.14
58.430 69.12
105.69 104.02

TWN RD
(GRAVEL)

| | * | DISTANCE |
|-----|-------------|----------|
| 1-2 | 0 | 47.71 |
| 1-3 | 56° 29' 52" | 173.14 |
| 1-4 | 82° 39' 32" | 163.30 |

RE-BAR w/RED CAP

RE-BAR w/RED CAP

ANGLES:

- A = 80° 35' 26"
- B = 27° 45' 40"
- C = 15° 09' 42"
- D = 69° 44' 33"
- E = 67° 19' 57"
- F = 16° 45' 10"
- G = 26° 10' 20"
- H = 56° 29' 12"

ANGLES AT CORNER FROM 1 TO 3 AND 2 TO 4 ARE 180°

TOPOGRAPHY

SURVEY ALIGNMENT

FIELD SURVEY NOTES

E-D-702 6-70

State of Wisconsin / Department of Transportation

APRIL 2 1991

RBJ SM GS

CORNER
E 11 T34N-R4E
BERNSTEIN MON.



164.120 173.14
58.430 69.12
105.69 104.02

TWN RD
(GRAVEL)


| | * | DISTANCE |
|-----|-------------|----------|
| 1-2 | 0 | 47.71 |
| 1-3 | 56° 29' 52" | 173.14 |
| 1-4 | 82° 39' 32" | 163.30 |

ANGLES:
A = 80° 35' 26"
B = 27° 45' 40"
C = 15° 09' 42"
D = 69° 44' 33"
E = 67° 19' 57"
F = 16° 45' 10"
G = 26° 10' 20"
H = 56° 29' 12"

ANGLES AT CORNER FROM 1 TO 3 AND 2 TO 4 ARE 180°

- TOPOGRAPHY
- SURVEY ALIGNMENT

CERTIFIED LAND CORNER RESTORATION

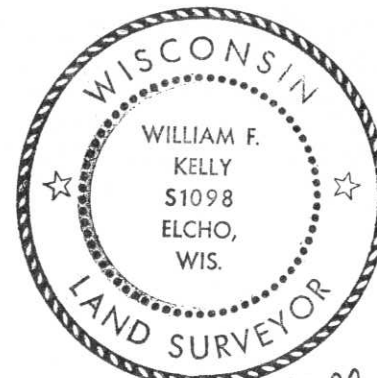


Index No. E-11

State of Wisconsin }
County of LINCOLN } ss.

I William F. Kelly, do hereby certify that on the 2nd day of AUGUST, 1974, I found evidence of the SOUTH 1/4 corner of SECT 4 Township 34, North, Range 4 EAST, Fourth, Principal Meridian, as described hereon; and that from this evidence I established a new monument and accessories as described hereon to perpetuate the original location of this corner.

Resident witnesses:

.....
.....
.....

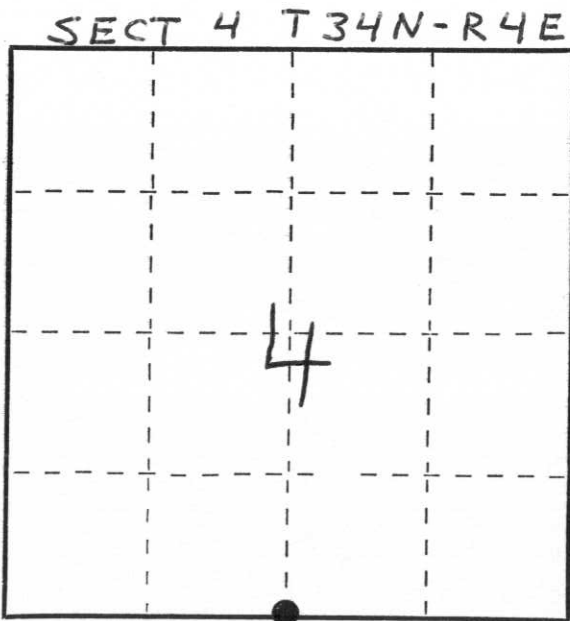

○ = Corner monument restored.

History of original corner establishment:


Description of corner evidence found:

LOCATED WITNESS CORNER 33 FT. SOUTH OF 1/4 COR

William F. Kelly 2 Aug. 1974

Description of monument and accessories I established to perpetuate the original location of this corner.

I set a LINCOLN CO. MONUMENT 1/2" BELOW THE ASPHALT SURFACE HGW 86

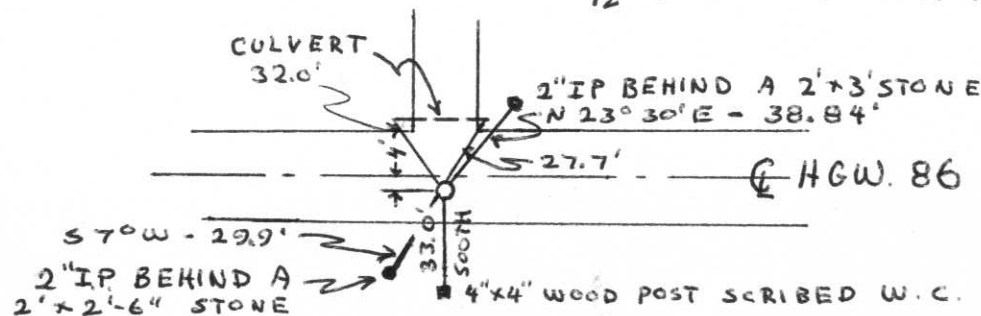

MON. MARKED
1/4 SECT COR
SECT 4
T34N R4E
WFK

Dated at ELCHO, Wis., this 2nd day of AUGUST, 1974.

Signature William F. Kelly Title Registered Land Surveyor Registration No. S-1098
(County Surveyor, Registered Land Surveyor, or other duly authorized official)

Office of Register of Deeds, County of _____, I hereby certify that the within instrument was filed in this office for record on the _____ day of _____, 19____ at _____ o'clock _____ M.

(Register of Deeds)

By _____ Deputy