


CERTIFIED LAND CORNER RESTORATION

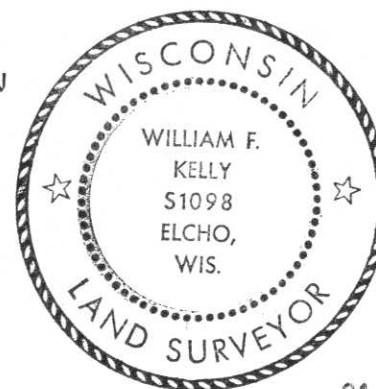

Index No. C-11

State of Wisconsin }
County of LINCOLN } ss.

History of original corner establishment:

I William F. Kelly do hereby certify that on the 2nd day of August, 1974, I found evidence of the center of Sect. corner of sect 4 Township 34, North, Range 4 East, Fourth, Principal Meridian, as described hereon; and that from this evidence I established a new monument and accessories as described hereon to perpetuate the original location of this corner.

Resident witnesses:

Description of corner evidence found:


Located Aspen Tree with Overgrown Blaze Mark
Followed Original Notes from S-1/4 COR SECT 4
TO EST. DISTANCE TO CENTER OF SECTION.
E-W 1/4 LINE INTERSECTED. COR. RESET AT
INTERSECTION

MON. MARKED
CENTER
SECT
4
T34N R4E
WFK

Description of monument and accessories I established to perpetuate the original location of this corner.
I set a LINCOLN CO. MONUMENT FLUSH WITH THE GROUND

8" ASPEN - OLD BLAZE AT BASE OF TREE

SECT 4 T34N-R4E

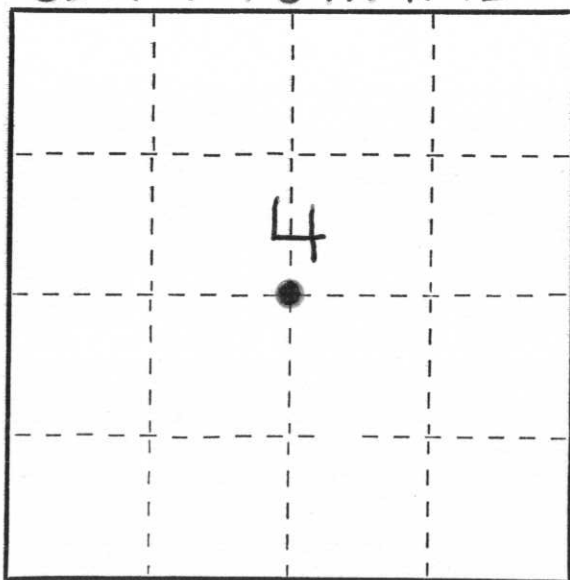

ROSS ROAD ENDS AT CORNER

NBT - 12" ASPEN

ROSS ROAD

33.0' 10" CEDAR POST

EAST

35.3'

S

43.45' E

2nd

P

30.40'

N

30.40'

W

ROSS ROAD

ROSS ROAD

Note: NBT BLAZED CHEST HIGH ON ALL 3 TREES AND A + BLAZED AT BASE OF TREES

Dated at ELCHO, Wis., this 2nd day of August, 1974.

Signature William F. Kelly Title Registered Land Surveyor Registration No. S-1098
(County Surveyor, Registered Land Surveyor, or other duly authorized official)

Office of Register of Deeds, County of _____, I hereby certify that the within instrument was filed in this office for record on the _____ day of _____, 19____ at _____ o'clock _____ M.

(Register of Deeds)

By _____ Deputy

○ = Corner monument restored.