

LINCOLN COUNTY U.S. PUBLIC LAND SURVEY MONUMENT LOCATION RECORD

LANDMARK BENCHMARK _____
 FOUND SET
 RESET
 RE-TIED

CORNER IDENTITY: BERNTSEN SNM1 STEEL NAIL MARKER
 LINCOLN COUNTY COORDINATE: N: 221912.663
 E: 309568.708

ELEVATION-(FEET): _____ DATUM: 83 (2011)

WEATHER: SUNNY

DATE OF SURVEY: 07/25/2019 TEMPERATURE: 83 °F

SURVEY PARTY: KEITH WALKOWSKI AND AUSTIN PELOT

BASIS FOR MONUMENT LOCATION:
 (DESCRIBE METHOD OF SURVEY AND CORNER AUTHENTICATION)

SEARCHED FOR THE SOUTH 1/4 CORNER OF SECTION 5
 AND FOUND A SMP NAIL ALONG WITH 3 OUT OF 4 TIES
 FROM THE 1992 TIESHEET. ADDED AN ADDITIONAL
 SDDR-130 AND SET A BERNTSTEN SNM1 STEEL NAIL
 MARKER UPON COMPLETION OF STH 86 PAVING PROJECT
 TO PERPETUATE THE CORNER LOCATION AS SHOWN
 BELOW.

FIELD BOOK NO. NA PAGE NO. NA

COMPANY RIVERSIDE LAND SURVEYING LLC

CERTIFIED CORRECT:

Keith J. Walkowski

KEITH J. WALKOWSKI S-2717
Professional Land Surveyor

DATE: OCTOBER 15TH, 2019

TIE SKETCH:

- SET BERNTSEN SNM1 STEEL NAIL MARKER
- FOUND 5/8" RED CAPPED REBAR
- SET BERNTSEN SDDR-130
- SET VINYL "T" POST

RECEIVED BY LINCOLN COUNTY
 SURVEYOR THIS 12TH DAY
 OF November 20 19
Terry Dahl
 COUNTY SURVEYOR

NOTE: CORNER LIES 5.65' SOUTH OF CENTERLINE


BEARINGS ARE BASED ON THE LINCOLN COUNTY COORDINATE SYSTEM NAD 83 (2011) AND REFERENCED AS SHOWN

THIS DRAWING IS NOT TO SCALE


SECTION 5
 TOWNSHIP 34 N
 RANGE 4 E

E-7
NO.

TOMAHAWK
 CITY, VILLAGE, TOWN

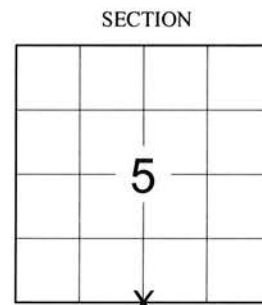

LOCATION
(Indicated By X)

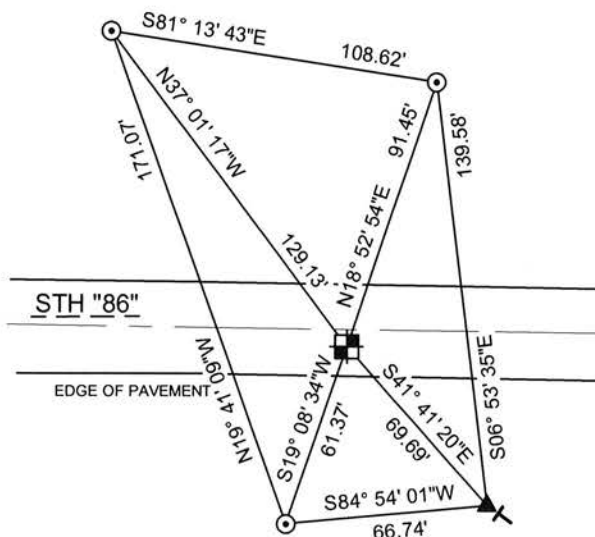

E-7
NO.


CERTIFIED LAND CORNER RESTORATION

Index No. E-7

State of Wisconsin }
 County of LINCOLN } ss.

I DAVID L LEMKE, do hereby certify that on the 14th day of NOVEMBER, 1988, I found evidence of the NORTH 1/4 corner of SECTION 8 Township 34 North, Range 4 EAST, Fourth Principal Meridian, as described hereon; and that from this evidence I established a new monument and accessories as described hereon to perpetuate the original location of this corner.

Resident witnesses:

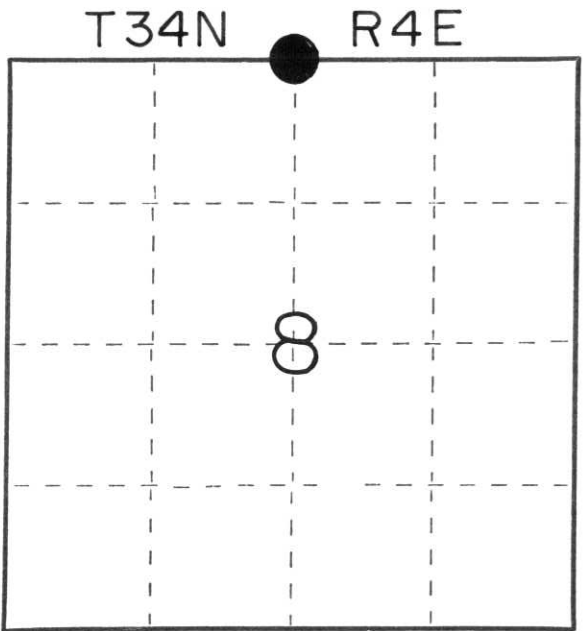

○ = Corner monument restored.

History of original corner establishment:


POST SET BY EDWARD PALMER APRIL 20, 1865

Description of corner evidence found:

2" X 2" IRON MONUMENT 18" BELOW ROAD SURFACE



Description of monument and accessories I established to perpetuate the original location of this corner.

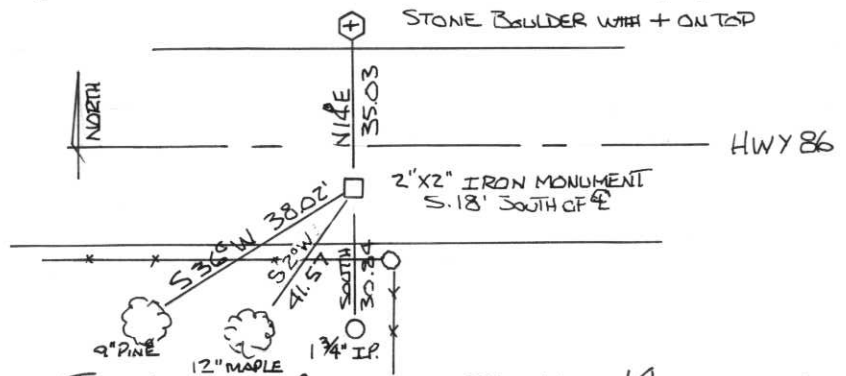

Dated at TOMAHAWK, Wis., this 14 day of NOVEMBER, 1988

Signature: David Lemke Title: REGISTERED LAND SURVEYOR Registration No. S-1845
 (County Surveyor, Registered Land Surveyor, or other duly authorized official)



Office of Register of Deeds, County of _____, I hereby certify that the within instrument was filed in this office for record on the _____ day of _____, 19____ at _____ o'clock _____ M.

 (Register of Deeds)
 By _____ Deputy

FORM 985 H.C. Miller Company Stock No. 26272

Horizontal — <u>2ND</u> Order	CONTROL DATUM Vertical — MEAN SEA LEVEL, 1929 ADJUSTMENT	East (X)	North (Y)	Elevation (Z)	Zone
	SURVEY CONTROL Vertical — _____ Order				

SKETCH

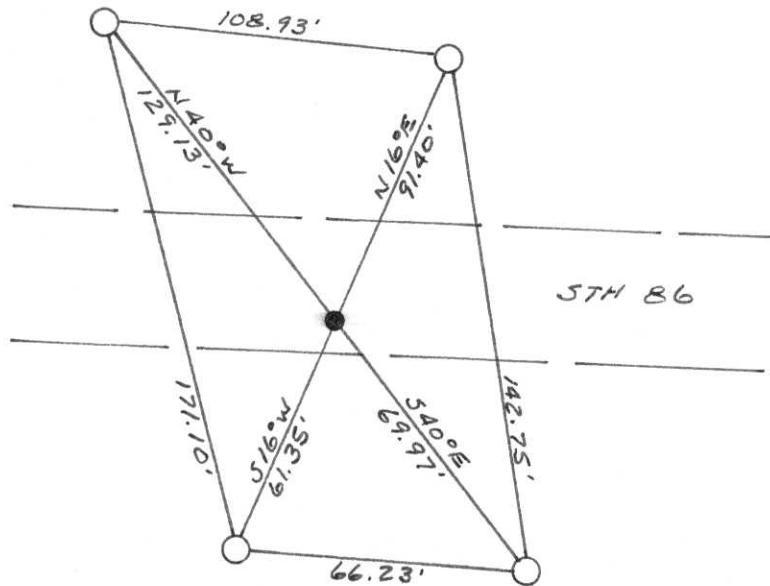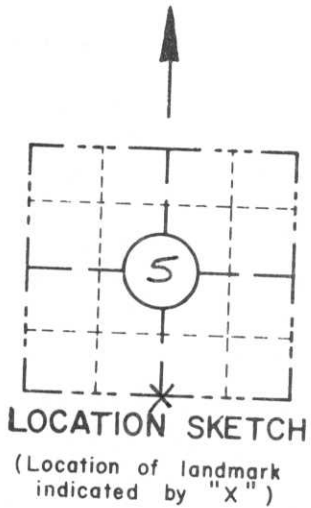

I hereby certify that on the 2ND day of APRIL 1992, that I did locate the above corner which was evidenced by 2" X 2" IRON MONUMENT

_____ ; I further certify that to perpetuate the location of such corner I did, at the exact location thereof, place a permanent marker consisting of _____

_____ ; I further certify that I did establish 4 references or witness monuments consisting of 5/8" X 24" RE-BARS WITH RED PLASTIC D.O.T. CAPS

_____ located as shown above:

SEAL

Signature Registered Land Surveyor	Registration No. S--	Title
------------------------------------	-------------------------	-------

CORNER
5/4
SECTION
5
TOWN
34 N
RANGE
4 E

FIELD SURVEY NOTES

E-D-702 6-70


State of Wisconsin / Department of Transportation

APRIL 2 1991
RBJ SM GS

CORNER
E 7 T34N-RAE
2" x 2" IRON MON.



152.745 199.105
61.35 69.975
91.395 129.130

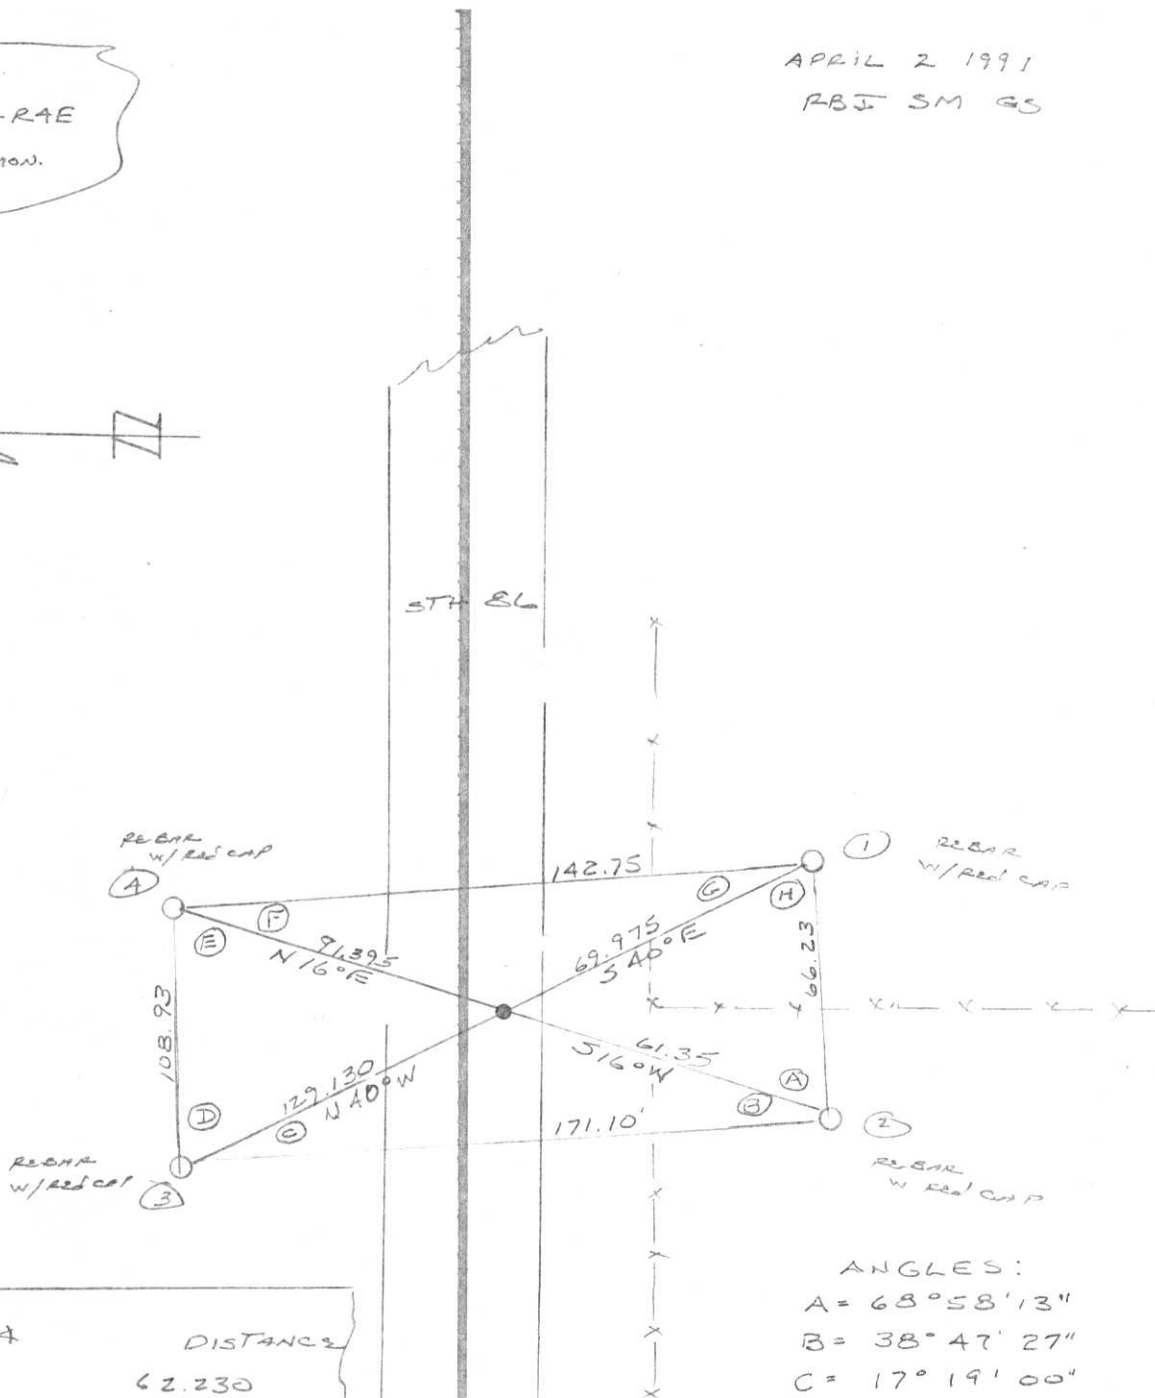

	4	DISTANCE
1-2	0	62.230
1-3	54° 55' 20"	199.105
1-4	87° 01' 52"	142.750

ANGLES:
A = 68° 58' 13"
B = 38° 47' 27"
C = 17° 19' 00"
D = 44° 08' 10"
E = 79° 45' 20"
F = 24° 00' 38"
G = 32° 05' 52"
H = 54° 55' 20"

ANGLES AT THE CORNER FROM 1 TO 3 AND 2 TO 4 ARE 180°

- TOPOGRAPHY
- SURVEY ALIGNMENT

E-7

RECEIVED JUN 18 1991

N 1/4 Sec 8
T34N R4E


State of Wisconsin | Department of Transportation

FIELD SURVEY NOTES

E-D-702 6-70

APRIL 2 1991
RBJ SM GS

CORNER
E 7 T34N-R4E
2"x2" IRON MON.

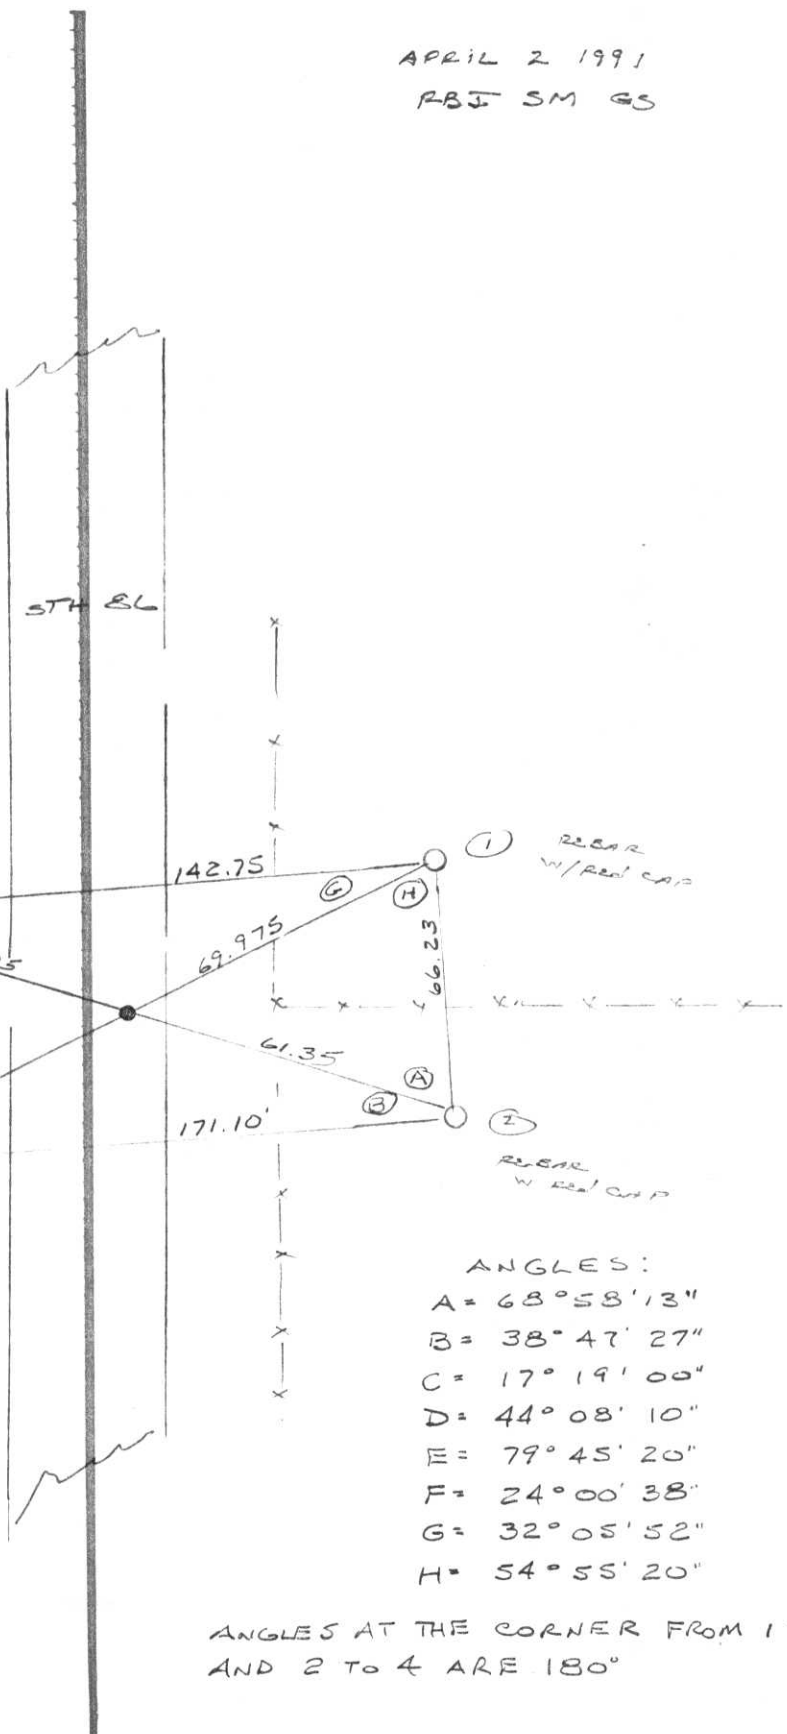

152.745 199.105
61.35 69.975
91.395 129.130

	∠	DISTANCE
1-2	0	62.230
1-3	54° 55' 20"	199.105
1-4	87° 01' 52"	142.750

ANGLES:
A = 68° 58' 13"
B = 38° 47' 27"
C = 17° 19' 00"
D = 44° 08' 10"
E = 79° 45' 20"
F = 24° 00' 38"
G = 32° 05' 52"
H = 54° 55' 20"

ANGLES AT THE CORNER FROM 1 TO 3
AND 2 TO 4 ARE 180°

- TOPOGRAPHY
- ALIGNMENT