

CERTIFIED LAND CORNER RESTORATION

Index No. C-5

State of Wisconsin }  
County of LINCOLN } ss.

I DAVID L. LEMKE, do hereby  
certify that on the 14<sup>th</sup> day  
of NOVEMBER, 1988, I found  
evidence of the EAST 1/4  
corner of SECTION 6  
Township 34, North, Range  
4 EAST, Fourth Principal Meridian,  
as described hereon; and that from this evidence  
I established a new monument and accessories  
as described hereon to perpetuate the original  
location of this corner.

Resident witnesses:



History of original corner establishment:

POST SET BY EDWARD PALMER APRIL 20, 1865

Description of corner evidence found:

Description of monument and accessories I established to perpetuate the original location of this corner.


SET BERNSTEIN MONUMENT  
LEVEL WITH SURFACE OF SWAMP

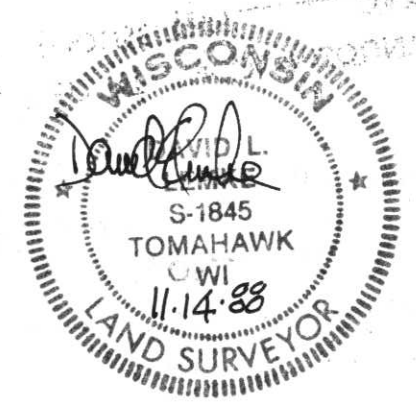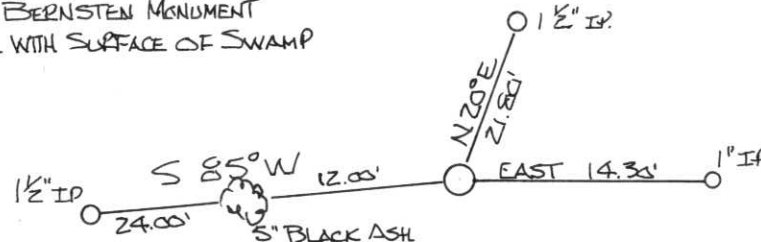

Stock No. 26272

H.C. Miller Company  
Surveyors & Instrument Makers

FORM 985

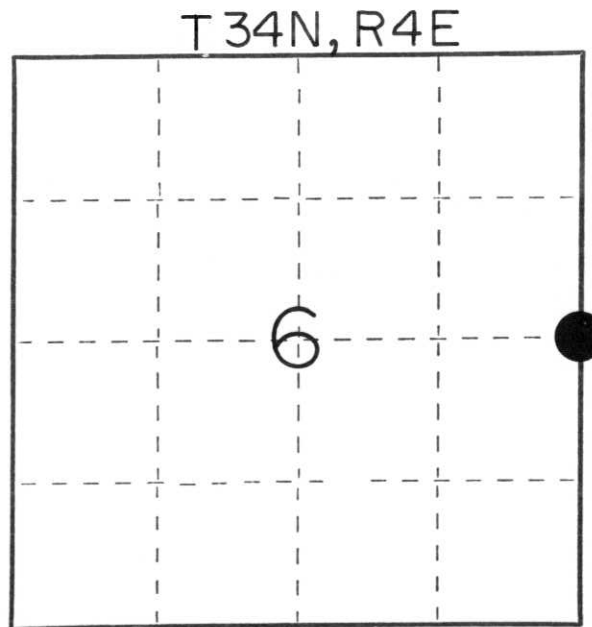

○ = Corner monument restored.

Dated at TOMAHAWK, Wis., this 14 day of NOVEMBER, 1988

Signature David L. Lemke Title REGISTERED LAND SURVEYOR Registration No. S-1845  
(County Surveyor, Registered Land Surveyor, or other duly authorized official)

Office of Register of Deeds, County of....., I hereby certify that the within  
instrument was filed in this office for record on the..... day of....., 19.....  
at..... o'clock..... M.

(Register of Deeds)

By..... Deputy