U.S. PUBLIC LAND SURVEY MONUMENT RECORD

NOTE: This form is intended and designed to fulfill all requirements of Wisconsin Administrative Code, Chapter A-E 7 .08 U.S. Public Land Survey Monument Record (3)(a)(b)(c)(d)(e)(f) (g)(h)(i). An additional sheet may be added if necessary to conform with said requirements.

(a)Corner location: Township 34 North

Range 4 East

TOMAHAWK Town of ___


County of _____LINCOLN

Lincoln County

N 217050.341

Coordinates

E 333459.605

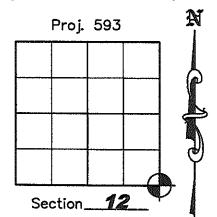

(b)(f)(g)(h) Description of monument found at this corner and if it was accepted, state all evidence (material, testimonial, occupation, plats, records, other monuments) used as a basis for accepting. If not accepted or if nothing was found, state evidence used as a basis for establishing location. If reestablished through lost comer proportionate methods, indicate all monuments, distances and directions used to establish. Indicate type of monument found or set and sign post.

August 1851 - James M. Marsh set original post. BT's: 14" Birch S50'E, 21 lks; Tamarack 15" S78"W 44 lks.; Black Cherry 8" N47"W 20 lks.; Sugar 24" N42"E 45 lks.

July 2, 1990 — R. C. Wylie set 1—1/2" iron pipe. BT's: 12" Stump NOE, No distance given; 8" Red Maple N70E 8.8'; 8" Red Maple S50"W 10.6'. He also notes that the corner lies on high ground at the West end of an island; See Plat of Survey dated August 1990, Lincoln County Land Information Office Map Number S110—D.

January 31, 2005 — Matthew E. Hoglund, subcontractor for the Plat of Survey by Stephen J. Favorite dated January 25, 2005, Lincoln County Land Information Office Map Number L396B. We found and accepted a 1-1/2" iron pipe and replaced it with a Lincoln County Berntsen Monument and set witness corners as shown below.

(c)(d)(e) Plan view of corner with ties to at least 4 witness monuments. If in disagreement with previously established corner, show the distances between the two corners and also indicate the ties to the disputed corner. Corner

Legend


7/8" x 30" IRON REBAR WITH ALUMINUM CAP SET

LINCOLN COUNTY BERNTSEN MONUMENT SET

Notes:

- The drawing is NOT to scale.
- 2. All bearings are taken with

a compass.

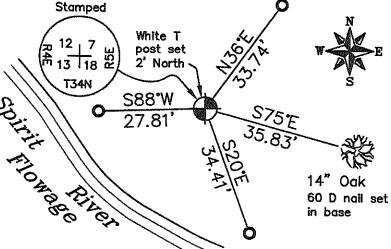

Qate

(i) I, Matthew E. Hoglund, certify that the corner location on this record was determined by me under my direction and control and that this U.S. Public Land Survey Monument is correct and complete to the best of my knowledge and belief.

Signature

TOMA.
WI
WI
SURVEYOR
MININGSON
MININ MATTHEW E.

RECEIVED BY LINCOLN COUNTY

SURVEYOR THIS 47H DAY

OF November 20 08 COUNTY SURVEYOR