
U.S. PUBLIC LAND SURVEY MONUMENT	RECORD
Note: This form is intended and designed to fulfill all requirements of Wisconsin Administration Public Land Survey Monument Record (3) (a) (b) (c) (d) (e) (f) (g) (h) (i). An additional strength conform with said requirements.	ive Code, Chapter A-E 5.02, U.S. neet may be added if necessary to
(a) Corner location: Township 34 North  Range 4 East	
Town Tomahawk	
CountyLincoln	
	Bection 13
b) (f) (g) (h) Description of monument found at this corner and if it was as	ccepted, state all evidence

(material, testimonial, occupational, plats, records, other monuments) used as a basis for accepting. If not accepted or if nothing was found, state evidence used as basis for establishing location. If reestablished through lost corner proportionate methods, indicate all monuments, distances and directions used to establish.

No corner or witness evidence found at this location. A lack of section or quarter section corners to the south and north precluded the use of double proportioning. The corner was established in the approximate center of Four Mile Road (road has a pronounced change in alignment here) in conjunction with 5 other section or quarter section corners found or set within 1.0 miles to the west and 2.0 miles to the east, adhering as much as possible to the same proportions found in the original survey (see map on other side).

c) (d) (e) Plan view of corner with ties to at least 4 witness monuments. If in disagreement with previously established corner, show the distances between the two corners and also Indicate the ties to the disputed corner.

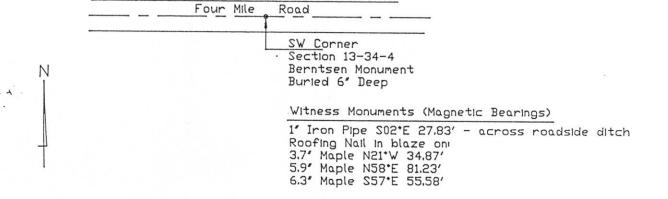


Robert C. Wylie, RLS-66

(type or print name) certify that the corner location on this record was determined by me or under my direction and control and that this U.S. Public Land Survey Monument Record is correct and complete to the best of my knowledge and belief.

Signature Date



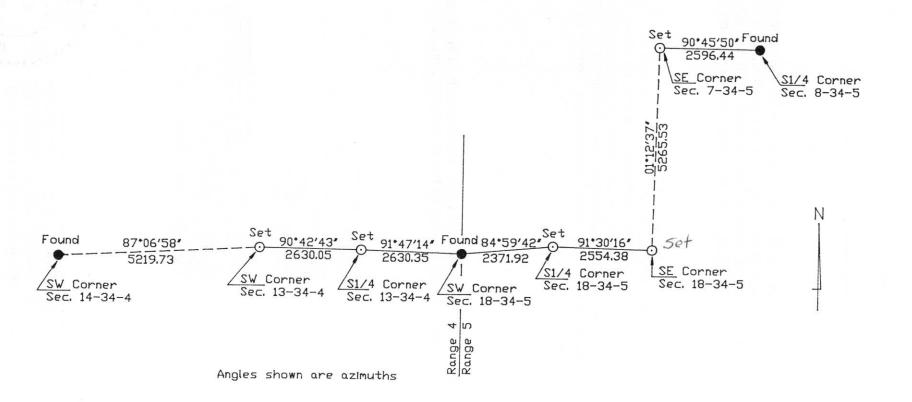

RECEIVED AT LINCOLN COUNTY

OF 19 90

TAX DESCRIPTION OFFICE