

# LINCOLN COUNTY U.S. PUBLIC LAND SURVEY MONUMENT LOCATION RECORD

SECTION 4  
 TOWNSHIP 34 N  
 RANGE 5 E

**E-11**

LANDMARK       BENCHMARK  
 CORNER IDENTITY: BERNTSEN ALUMINUM MONUMENT

FOUND   
 SET   
 RESET   
 RE-TIED

LINCOLN COUNTY COORDINATE: N: 222587.600  
 E: 346415.734


ELEVATION-(FEET): \_\_\_\_\_ DATUM: \_\_\_\_\_

WEATHER: PARTLY CLOUDY

DATE OF SURVEY: 10/09/2019 TEMPERATURE: 60 °F

SURVEY PARTY: KEITH WALKOWSKI AND AUSTIN PELOT

TOMAHAWK  
 CITY, VILLAGE, TOWN

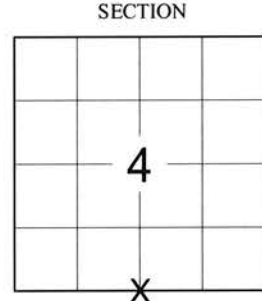

LOCATION  
(Indicated By X)



**BASIS FOR MONUMENT LOCATION:**  
 (DESCRIBE METHOD OF SURVEY AND CORNER AUTHENTICATION)

SEARCHED FOR THE SOUTH 1/4 CORNER OF SECTION 4 AND DID NOT FIND A MONUMENT BUT FOUND ALL 4 TIES FROM THE 1991 TIESHEET BY R.B. JOHNSON. INTERSECTED THE TIES AND SET A BERNTSEN ALUMINUM MONUMENT AT THE CORNER IN THE SHOULDER OF ROAD UPON COMPLETION OF THE STH "86" RESURFACING PROJECT TO PERPETUATE THE CORNER LOCATION AS SHOWN BELOW.




CERTIFIED CORRECT:  
Keith J. Walkowski  
 KEITH J. WALKOWSKI S-2717  
 Professional Land Surveyor  
 DATE: OCTOBER 15TH, 2019

FIELD BOOK NO. NA PAGE NO. NA  
 COMPANY RIVERSIDE LAND SURVEYING LLC

**TIE SKETCH:**

- SET BERNTSEN ALUMINUM MONUMENT
- FOUND 5/8" CAPPED REBAR
- SET VINYL "T" POST

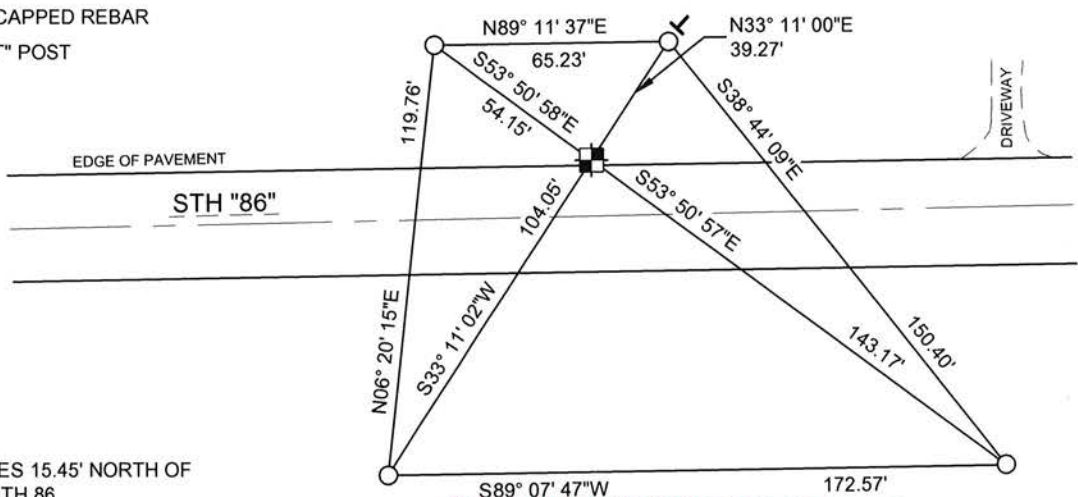

NOTE: CORNER LIES 15.45' NORTH OF CENTERLINE OF STH 86  
 BEARINGS ARE BASED ON THE LINCOLN COUNTY COORDINATE SYSTEM NAD 83 (2011) AND REFERENCED AS SHOWN

THIS DRAWING IS NOT TO SCALE

RECEIVED BY LINCOLN COUNTY SURVEYOR THIS 12TH DAY OF November 20 19  
Tony Duber  
 COUNTY SURVEYOR

**E-11**  
 NO.



RECORD AND CERTIFICATION OF U.S. PUBLIC LAND SURVEY CONTROL STATION

State of Wisconsin / Department of Transportation

E-D-716-72

|                                   |                             |   |                   |                        |  |
|-----------------------------------|-----------------------------|---|-------------------|------------------------|--|
| District<br>7                     | Project I. D.<br>9215-06-00 | Located by<br>R.B. JOHNSON - SURVEY CREW CHIEF              |                   |                        |  |
| Corner<br>S 1/4 COR 4 SECTION     | Township<br>34 N            | Range (E,W)<br>5 E  | County<br>LINCOLN |                        |  |
| Wisconsin Coordinates<br>CORNER   | East (X)<br>2,033,890.72    | North (Y)<br>591,181.59                                     | Elevation (Z)     | Zone<br>C              |  |
| Control Station Name              | East (X)                    | North (Y)   | Elevation (Z)     | Zone                   |  |
| Horizontal — NORTH AMERICAN, 1927 |                             | CONTROL DATUM<br>Vertical — MEAN SEA LEVEL, 1929 ADJUSTMENT |                   |                        |  |
| Horizontal — 2ND Order            |                             | SURVEY CONTROL  |                   | Vertical — _____ Order |  |

SKETCH

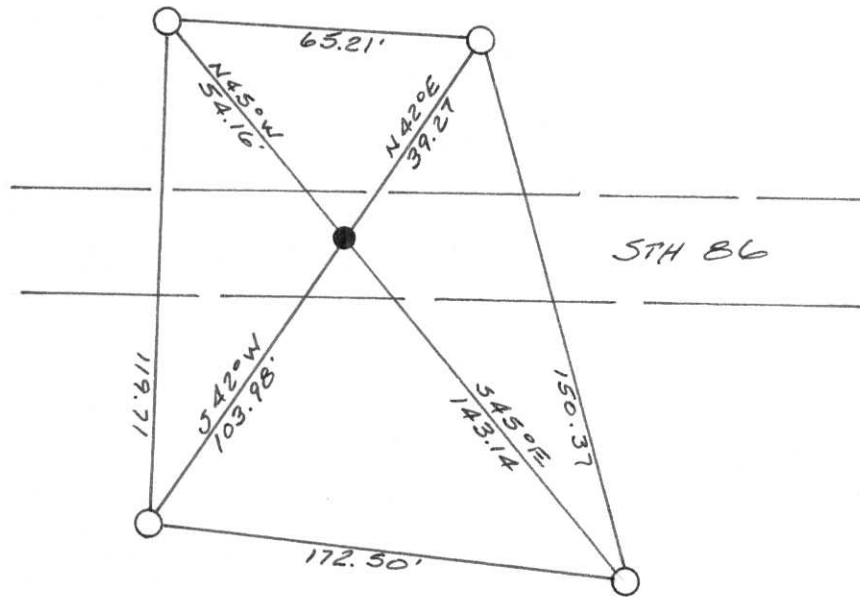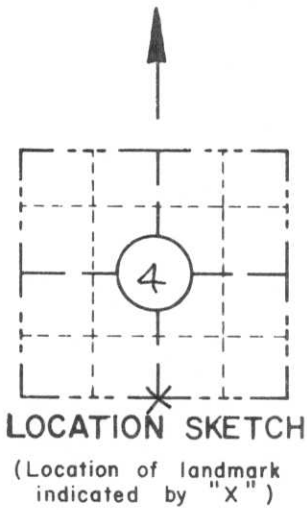

I hereby certify that on the 8TH day of APRIL 1991, that I did locate the above corner which was evidenced by A BERNTSEN ALUMINUM MONUMENT; I further certify that to perpetuate the location of such corner I did, at the exact location thereof, place a permanent marker consisting of \_\_\_\_\_

\_\_\_\_\_ ; I further certify that I did establish 4 references or witness monuments consisting of 5/8" X 24" RE-BARS WITH D.O.T. RED PLASTIC CAPS

\_\_\_\_\_ located as shown above:

SEAL

|                                    |                         |       |
|------------------------------------|-------------------------|-------|
| Signature Registered Land Surveyor | Registration No.<br>S-- | Title |
|------------------------------------|-------------------------|-------|

CORNER  
S 1/4 COR.  
SECTION  
4  
TOWN  
34 N  
RANGE  
5 E


CERTIFIED LAND CORNER RESTORATION

Index No. E-11

State of Wisconsin }  
County of Lincoln } ss.

I Lester J. Schmit, do hereby certify that on the \_\_\_\_\_ day of \_\_\_\_\_, 1984, I found no evidence of the North 1/4 corner of Section 9 Township 34, North, Range 5 East, Fourth, Principal Meridian, as described hereon; and that from ~~the~~ <sup>other</sup> evidence I established a new monument and accessories as described hereon to perpetuate the ~~original~~ location of this corner.

Resident witnesses:

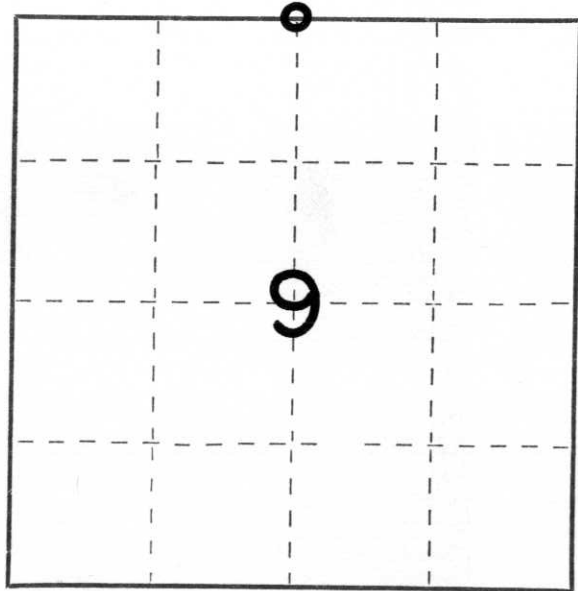

○ = Corner monument restored.

History of original corner establishment:

Surveyor: Jackson L. Prentice  
Date: January 1855  
Monumentation: Wood Post  
Witnesses: 11" Aspen, N 18° E, 28 links  
12" Aspen, S 20° W, 25 links

Description of corner evidence found: I found no monument or evidence for the corner location. By retracing a survey done by F.R. Wincentzen in March 1964 and revised by Robert E. Bandow on 9 April 1968, the corner would lie on the centreline of State Trunk Highway "86".

Description of monument and accessories I established to perpetuate the ~~original~~ location of this corner.

Set a Berntsen monument flush with the surface of highway for corner.

Witnessed by: 1" iron pipe, N 66° E, 82.16'  
10" sugar maple, S 17° E, 35.30'  
6" white birch, S 23° W, 41.91'  
power pole, N 1° W, 37.61'

Dated at Tomahawk, Wis., this 10<sup>th</sup> day of May, 1984

Signature Lester J. Schmit Title Land Surveyor Registration No. S-1192  
(County Surveyor, Registered Land Surveyor, or other duly authorized official)

Office of Register of Deeds, County of \_\_\_\_\_, I hereby certify that the within instrument was filed in this office for record on the \_\_\_\_\_ day of \_\_\_\_\_, 19 \_\_\_\_\_ at \_\_\_\_\_ o'clock \_\_\_\_\_ M.

(Register of Deeds)

By \_\_\_\_\_ Deputy

FIELD SURVEY NOTES


E-D-702 6-70

State of Wisconsin | Department of Transportation

CORNER E11  
T34N-R5E  
BERNSTEIN MON.

APRIL 8, 1991

RRJ, SM, GS, BT

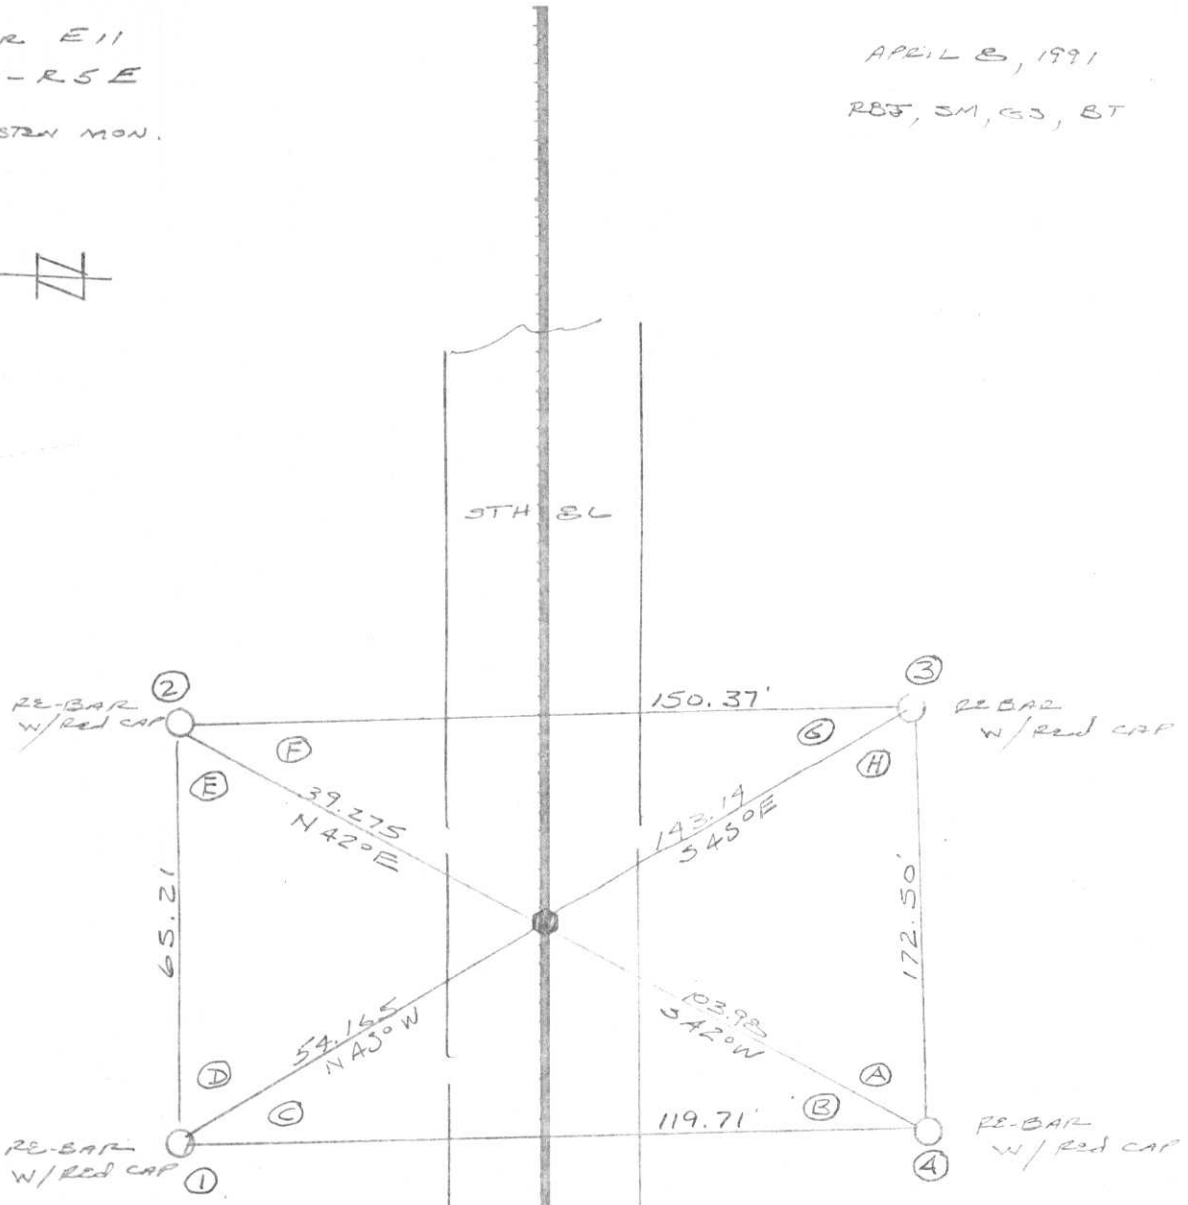

143.255  
39.275  
-----  
103.980

197.305  
54.165  
-----  
143.140

|     | A           | DIST    |
|-----|-------------|---------|
| 1-2 | 0           | 65.215  |
| 1-3 | 36° 56' 02" | 197.305 |
| 1-4 | 97° 08' 46" | 119.705 |

- ANGLES:
- A: 55° 57' 50"
  - B: 26° 51' 47"
  - C: 60° 09' 42"
  - D: 36° 56' 02"
  - E: 56° 02' 29"
  - F: 71° 55' 09"
  - G: 15° 06' 21"
  - H: 37° 00' 41"

ANGLES AT CORNER FROM 1 TO 3 AND 2 TO 4 ARE 180°

- TOPOGRAPHY
- SURVEY ALIGNMENT

11-1

FIELD SURVEY NOTES  
E-D-702 6-70


RECEIVED JUN 18 1991

N/14 Sec 9  
T34N R5E  
State of Wisconsin / Department of Transportation

CORNER E11  
T34N-R5E  
BERNSTEIN MON.

APRIL 8, 1991

RBJ, SM, GS, BT

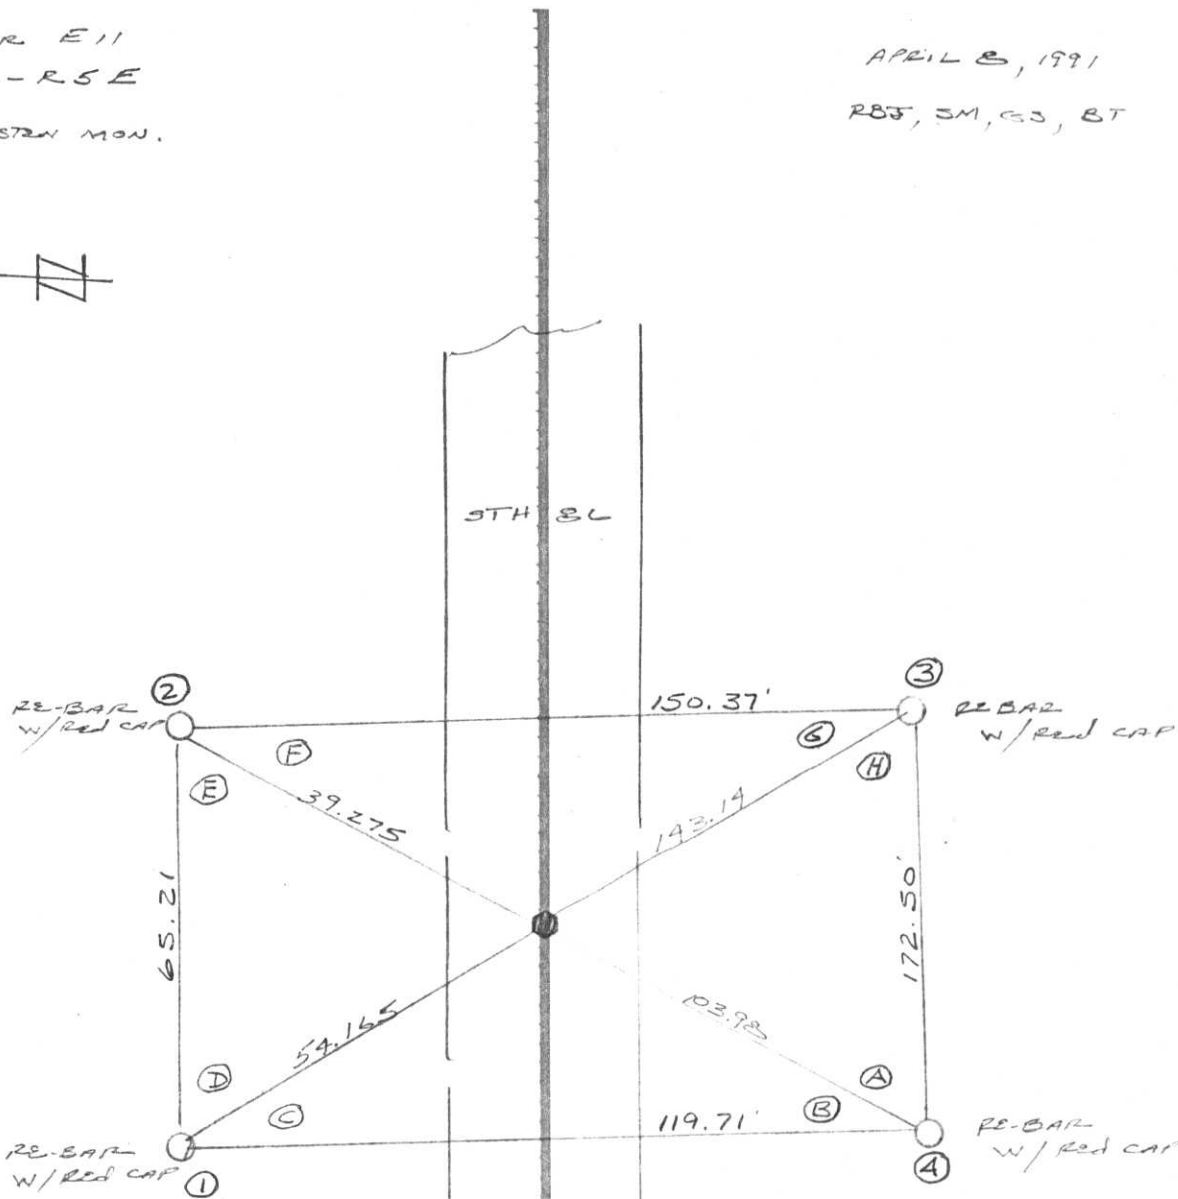

|         |
|---------|
| 143.255 |
| 39.275  |
| -----   |
| 103.980 |

|         |
|---------|
| 197.305 |
| 54.165  |
| -----   |
| 143.140 |

ANGLES:

- A: 55° 57' 50"
- B: 26° 51' 47"
- C: 60° 09' 42"
- D: 36° 56' 02"
- E: 56° 02' 29"
- F: 71° 55' 09"
- G: 15° 06' 21"
- H: 37° 00' 41"

ANGLES AT CORNER FROM 1 TO 3  
AND 2 TO 4 ARE 180°

|     | A           | DIST    |
|-----|-------------|---------|
| 1-2 | 0           | 65.215  |
| 1-3 | 36° 56' 02" | 197.305 |
| 1-4 | 97° 02' 46" | 119.705 |

TOPOGRAPHY  
 SURVEY ALIGNMENT