LINCOLN COUNTY U.S. PUBLIC LAND CORNER NUMBER	
SURVEY MONUMENT LOCATION RECORD SECTION 8	
TOWNSHIP34	_ ()
FOUND RANGE 5E	$ \bigcirc$
LANDMARK BENCHMARK SET TOMAHAWK RESET CITY, VILLAGE, TOWN	NO.
CORNER IDENTITY: FOUND BERNSTEN MONUMENT RE-TIED	1
LINCOLN COUNTY COORDINATE: N: 217178.1470	1
E: 338471.3130	\
ELEVATION-(FEET): DATUM:	7
WEATHER: CLEAR	N I
DATE OF SURVEY: 4-28-08 TEMPERATURE: 40 *F	IV
SURVEY PARTY: N.W./J.P.	
BASIS FOR MONUMENT LOCATION: (DESCRIBE METHOD OF SURVEY AND CORNER AUTHENTICATION) LOCATION (Indicated By X)	CON
(DESCRIBE METHOD OF SURVEY AND CORNER AUTHENTICATION) (Indicated By X)	NATHAN
THE BERNSTEN MONUMENT THAT WAS SHOWN ON PERVIOUS TIE SHEET	J. Wasan Till
WAS FOUND. THE MONUMENT WAS ACCEPTED AS THE CORNER LOCATION. ONE TIE TO THIS CORNER WAS FOUND AND THE MISSING TIES WERE	S-2539
REPLACED AS SHOWN.	NCENTSEN WAUSAU
	WI Server J May
	CIID A HABBER
CERTIFIED CORRECT:	ASSESSED TO THE PROPERTY OF THE PARTY OF THE
FIELD BOOK NO. 17 PAGE NO. 37	EART TH
COMPANY RIVERSIDE LAND SURVEYING, LLC Registered Land Surveying DATE: 5-79-08	yor yor
- DAIL. J. J. G	
TIE SKETCH: SHOW MINIMUM OF FOUR (4) HORIZONTAL TIE DISTANCES TO FIXED WITNESS MONUMEN	TS.
DESCRIBE ALL MONUMENTS FOUND OR SET. CORRECT ALL DISTANCES SHOWN TO STAN TEMPERATURE OF 68° F.	DARD
TWIN 16" MAPLE FOUND BERNSTEN MONUMENT SWAMP AREA	
-FOUND BERNSTEN MONUMENT -SET 3/4" REBAR WITH ALUMINUM CAPS -VINYL SURVEY MARKER POST S88°39'36"E 10" BALSAN	
T -VINYL SURVEY MARKER POST	
© -FOUND 1" IRON PIPE 588°39'36"E 10" BALSAN	4
, XO, 30.63	
121 34'	
POWER POLE 2 S82°46'12"W S27°15'03"E	
307 10 04 VV	
NOTE <u>#</u> <u>#</u> 31.36' 28.81'	
NOTE - ALL BEARINGS ARE REFERENCED TO THE LINCOLN SOUNTY COORDINATE SWAMP AREA W W 31.36' SWAMP AREA	
NOTE - ALL BEARINGS ARE REFERENCED TO THE LINCOLN COUNTY COORDINATE SYSTEM WWW 31.36' SWAMP AREA 6" BALSAM 6" BALSAM	
NOTE - ALL BEARINGS ARE REFERENCED TO THE LINCOLN COUNTY COORDINATE SYSTEM - THIS DRAWING IS NOT TO SCALE W 31.36' SWAMP AREA W 6" BALSAM WOOD ROPE WOOD ROPE WOOD ROPE WHOOD ROP	
- ALL BEARINGS ARE REFERENCED TO THE LINCOLN COUNTY COORDINATE SYSTEM - THIS DRAWING IS NOT TO SCALE RECEIVED BY LINCOLN COUNTY	
- ALL BEARINGS ARE REFERENCED TO THE LINCOLN COUNTY COORDINATE SYSTEM - THIS DRAWING IS NOT TO SCALE SUMMP AREA WOOD ROAD 6" BALSAM	
- ALL BEARINGS ARE REFERENCED TO THE LINCOLN COUNTY COORDINATE SYSTEM - THIS DRAWING IS NOT TO SCALE RECEIVED BY LINCOLN COUNTY	
- ALL BEARINGS ARE REFERENCED TO THE LINCOLN COUNTY COORDINATE SYSTEM - THIS DRAWING IS NOT TO SCALE RECEIVED BY LINCOLN COUNTY SURVEYOR THIS 20 TH DAY	

U.S. PUBLIC LAND SURVEY MONUMENT RECORD


Note: This form is intended and designed to fulfill all requirements of Wisconsin Administrative Code, Chapter A-E 5.02, U.S. Public Land Survey Monument Record (3) (a) (b) (c) (d) (e) (f) (g) (h) (i). An additional sheet may be added if necessary to conform with said requirements.

(a) Corner location: Township 34 North

Range__5_East

Town Tomahawk


County _____Lincoln

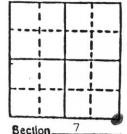

b) (f) (g) (h) Description of monument found at this corner and if it was accepted, state all evidence (material, testimonial, occupational, plats, records, other monuments) used as a basis for accepting. If not accepted or if nothing was found, state evidence used as basis for establishing location. If reestablished through lost corner proportionate methods, indicate all monuments, distances and directions used to establish.

Found a flagged spike in the ground at this location with no witness trees. Could not find Stuth iron pipe and only one of two witnesses from his earlier survey. Used spike location during extensive resurvey work in the area (see map on other side). Found later that Stuth Section 7 subdivision corners were in error due to miscalculation and while resetting those corners and closing out on the SE corner of Section 7 (spike location) the Stuth pipe was found 34.76' west. However, the spike location agreed much better with survey data by Wisconsin Valley Improvement Company in the late 1920s or early 1930s. A Berntsen monument was placed at the spike location with the cap just above the ground surface.

c) (d) (e) Plan view of corner with ties to at least 4 witness monuments. If in disagreement with previously established corner, show the distances between the two corners and also indicate the ties to the disputed corner.

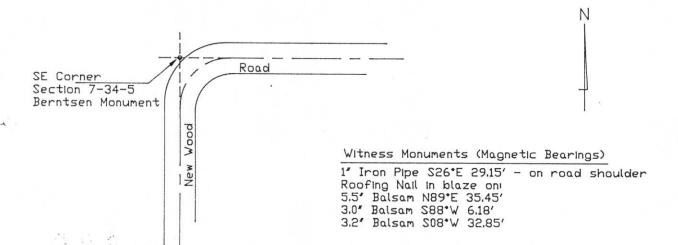

(i) I. Robert C. Wylie, RLS-66


(type or print name) certify that the corner location on this record was determined by me or under my direction and control and that this U.S. Public Land Survey Monument Record is correct and complete to the best of my knowledge and belief.

Signature Signature

Aug 2,1990
Date



Index No. 2-5

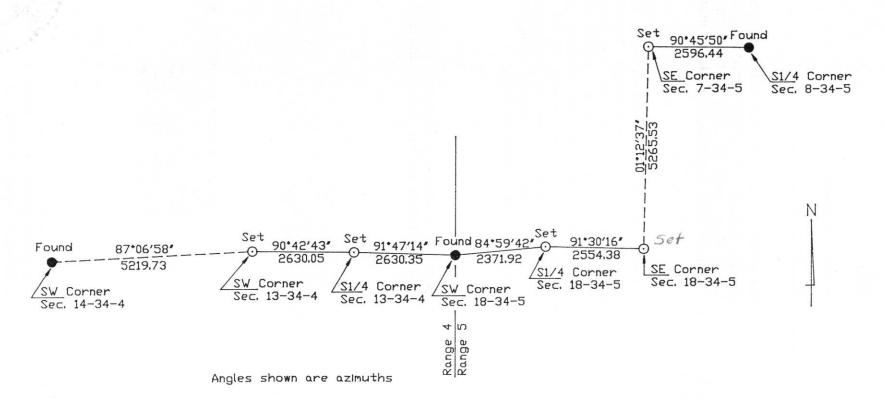

TAX DESCRIPTION OFFICE

COURTHOUSE THIS ICOURTHOUSE 19 90

RECEIVED AT LINCOLN COUNTY