


# U.S. PUBLIC LAND SURVEY MONUMENT RECORD

NOTE: This form is intended and designed to fulfill all requirements of Wisconsin Administrative Code, Chapter A-E 7.08 U.S. Public Land Survey Monument Record (3)(a)(b)(c)(d)(e)(f)(g)(h)(i). An additional sheet may be added if necessary to conform with said requirements.

(a) Corner location: Township 34 North  
 Range 05 East  
 Town of TOMAHAWK  
 LINCOLN County, Wisconsin

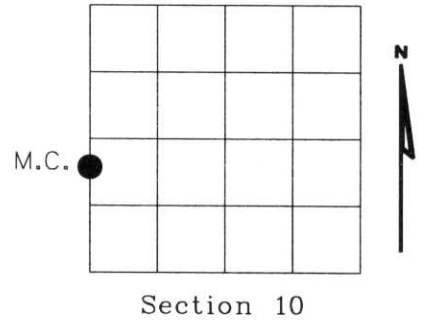

Section 10


(b)(f)(g)(h) Description of monument found at this corner and if it was accepted, state all evidence (material, testimonial, occupational, plats, records, other monuments) used as a basis for accepting. If not accepted or if nothing was found, state evidence used as basis for establishing location. If reestablished through lost corner proportionate methods, indicate all monuments, distances and directions used to establish. Indicate type of monument found or set and sign post.

1865 - EDWARD O'PALMER-DID NOT SET MEANDER CORNER.

1980 - JOHN H. FISHER S-836, CERTIFIED SURVEY MAP#262337  
 FOUND A 2" DIAMETER IRON PIPE  
 B.T.'S  
 10" MAPLE N 19° W, 3.5'  
 8" YELLOW BIRCH S 43° W, 35.2'

2000 - I FIND 2" DIAMETER IRON PIPE AND JOHN H. FISHER B.T.'S.  
 ACCEPTED AS MEANDER CORNER BETWEEN SECTIONS 9&10  
 AND REPLACED WITH A LINCOLN COUNTY BERNTSEN  
 MONUMENT AND SET WITNESSES AS SHOWN BELOW.

(c)(d)(e) Plan view of corner with ties to at least 4 witness monuments. If in disagreement with previously established corner, show the distances between the two corners and also indicate the ties to the disputed corner.

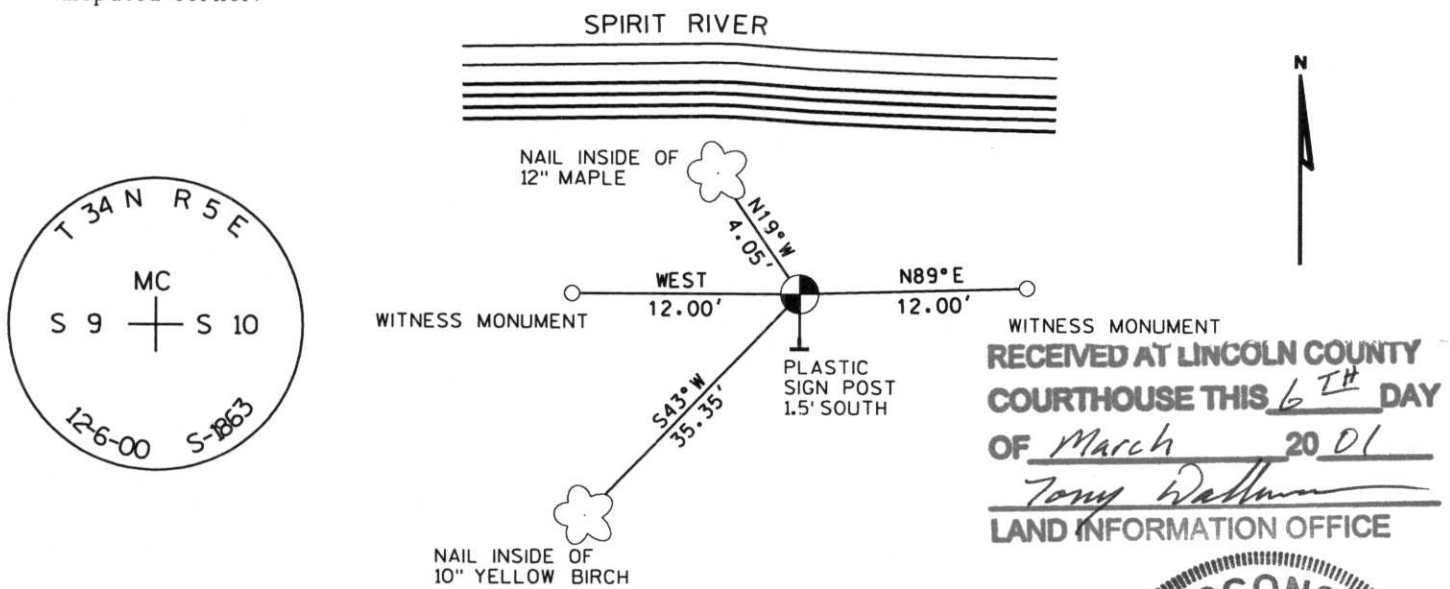

(i) I, Dennis B. Roberts, Registered Land Surveyor \*S-1863, hereby certify that the corner location on this record was determined by me or under my direction and control and that this U.S. Public Land Survey Monument Record is correct and complete to the best of my knowledge and belief.



Dennis B. Roberts 02-27-2001  
 Signature Date

Index No. G, H-13