U.S. PUBLIC LAND SURVEY MONUMENT RECORD


NOTE: This form is intended and designed to fulfill all requirements of Wisconsin Administrative Code, Chapter A-E 7.08 U.S. Public Land Survey Monument Record (3)(a)(b)(c)(d)(e)(f)(g)(h)(i). An additional sheet may be added if necessary to conform with said requirements.

(a) Corner location: Township 34 North

Range 05 East

Town of TOMAHAWK

LINCOLN County, Wisconsin

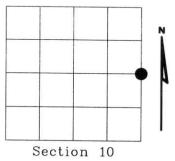


(b)(f)(g)(h) Description of monument found at this corner and if it was accepted, state all evidence (material, testimonial, occupational, plats, records, other monuments) used as a basis for accepting. If not accepted or if nothing was found, state evidence used as basis for establishing location. If reestablished through lost corner proportionate methods, indicate all monuments, distances and directions used to establish. Indicate type of monument found or set and sign post.

1865 - EDWARD O' PALMER 40.00 CHAINS, SET QUARTER POST B.T.'s

BIRCH 12" S 27° E, 14 LKS. MAPLE N 64° W, 26 LKS.

2000 - DENNIS B. ROBERTS, FOUND 2" DIAMETER IRON PIPE, WITH BLUE PAINTED LINES NORTH AND EAST - TIMBER CUT TO WEST AND SOUTH. ACCEPTED THIS AS BEST EVIDENCE. SET LINCOLN COUNTY BERNTSEN MONUMENT AND SET WITNESSES AS SHOWN BELOW.

(c)(d)(e) Plan view of corner with ties to at least 4 witness monuments. If in disagreement with previously established corner, show the distances between the two corners and also indicate the ties to the disputed corner.

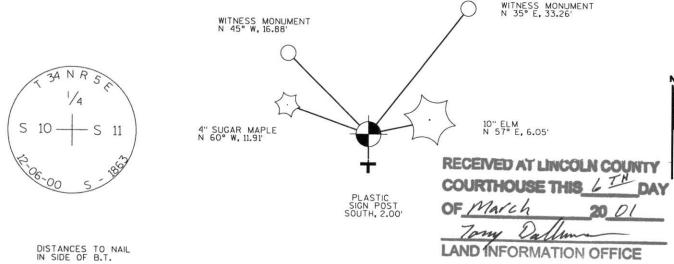

(i) I, Dennis Roberts, Registered Land Surveyor *S-1863, hereby certify that the corner location on this record was determined by me or under my direction and control and that this U.S. Public Land Survey Monument Record is correct and complete to the best of my knowledge and belief.

1005-75-20 Signature











