## U.S. PUBLIC LAND SURVEY MONUMENT RECORD

Note: This form is intended and designed to fulfill all requirements of the Wisconsin Administrative Code, Chapter A-E 7.08 U.S. Public Land Monument Record (3)(a)(b)(c)(d)(e)(f)(g)(h)(i). An additional sheet may be added if necessary to confrom with said requirements.

(a) CORNER LOCATION:

east quarter corner Section 15

Township 34 North

Range 5 East Town of Tomahawk

County of Lincoln

LINCOLN COUNTY COORDINATE SYSTEM, BASED ON GPS CONTROL SUPPLIED FROM THE COUNTY

SURVEYORS OFFICE.

North: 214,472.010 East: 354296.838



SECTION 15

(b) HISTORY OF ORIGINAL CORNER ESTABLISHMENT

Original Surveyor: J.L. Prentice

Date of Survey: Commenced July 1855

Completed July 1855

Original B.T.'S

Spruce 10" dia., N43°E 16 links

Spruce 11" dia., N68°W 29 links

(f)(g)(h) DESCRIPTION OF MONUMENT FOUND AT THIS CORNER AND IF IT WAS ACCEPTED, STATE ALL EVIDENCE (MATERIAL, TESTIMONIAL, OCCUPATIONS, PLATS, RECORDS, OTHER MONUMENTS) USED AS A BASISFOR ESTABLISHING LOCATION. IF NOT ACCEPTED OF IF NOTHING WAS FOUND, STATE EVIDENCE USED AS BASIS FOR ESTABLISHING LOCATION. IF REESTABLISHED THROUGH LOST CORNER PROPORTIONATE METHODS, INDICATE ALL MONUMENTS, DISTANCES AND DIRECTIONS USED TO ESTABLISH. INDICATE TYPE OF MONUMENT AND SIGN POST FOUND OR SET.

Original surveyor: J.L. Prentice, north 40 chains set quarter section post for sections 14 & 15

Company & date unknown: iron pipe and aluminum location tag attached to 10" dia. Aspen tree, tag states the the iron pipe 14 feet south is one-quarter corner.

Michael L. Oestreich: December 2007, found above mentioned iron pipe and aluminum witness tag. I replaced the iron pipe with a Berntsen aluminum monument and made witness ties as shown in the plan below. See Map No. 07-37(2) by Oestreich Surveying & Mappipng, LLC, dated 1/02/08, for complete subdivision of Section 15.

(c)(d)(e) PLAN VIEW OF CORNER WITH TIES TO AT LEAST 4 WITNESS MONUMENTS. IF IN DISAGREEMENT WITH PREVIOUSLY ESTABLISHED CORNER, SHOW THE DISTANCE BETWEEN THE TWO CORNERS AND ALSO INDICATE THE TIES TO THE DISPUTED CORNER.



Bearings magnetic




Scale 1"= 20"

= Set aluminum capped 0.87" dia. x 30" long iron rod.

Replaced found 1.9" dia. iron pipe with a Berntsen Alum. Mon.,



10" dia. Aspen with location tag.

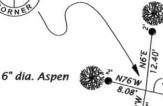

6" dia. Aspen

(i) I, MICHAEL L. OESTREICH, REGISTERED LAND SURVEYOR NO. S-2118 HEREBY CERTIFY THAT THE CORNER LOCATION ON THIS RECORD WAS DETERMINED BY ME OR UNDER MY DIRECTION AND CONTROL AND THAT THIS U.S. PUBLIC LAND SURVEY MONUMENT RECORD IS CORRECT AND COMPLETE TO THE BEST OF MY KNOWLEDGE AND RECEIVED BY LINCOLN COUNTY BELIEF.

6" dia. W. Birch

SURVEYOR THIS 5 TH DAY

COUNTY SURVEYOR

Michel Destrue 2/01 SIGNATURE

NO